

Name John Plugis
Address 101 Bedford Street

Service No. 3373
2095

Location 101 Bedford Street

Kind of Pipe
Size
Size of Main
Location

~~Repair~~ ~~Bedford~~ — New Service

Date	Material	Amount	Total	Date	Amount
Oct. 4, '47	Labor	1 10	1 10	Sept 29 '47	40 00
	10% Overhead		11	Dec 4 '47	5 07
	57' - 3/4" Copper Tubing @ .26	14 82	14 82		34 93
	1 - 3/4" C x 1/2" I.W.H. S & W	3 15	3 15	Oct. 3, '47	48 50
	Patching 15 x 3	15 00	15 00	"	9 96
	Trucking 1 hr. @ .75		75	29' - 3/4" Copper Tubing @ .26	7 54
			34 93	1 - 3/4" C Corp-cock	3 00
				1 - 3/4" C x 3/4" C Curb-cock	3 68
				1 - Box & Rod	4 26
				1 - 1/2" Straight Tail Piece	30
				1 - 1/2" Offset Tail Piece	30
				Compressor 6 hrs. @ 1.75	10 50
	Labor			Trucking 1 hr. @ .75	75
					78 79

Deposited
Refunded
Non-Charge

DATE _____

TOWN OF LEXINGTON - BOARD OF PUBLIC WORKS

WATER DIVISION

The undersigned applies for a supply of water at No..... St. and hereby agrees to comply with the rules and regulations as now, or at any future time, established by the Board of Selectmen.

Am't of Estimate \$.....

Owner


Am't Paid \$.....

Address

Builder

.....

Sketch of Service Here

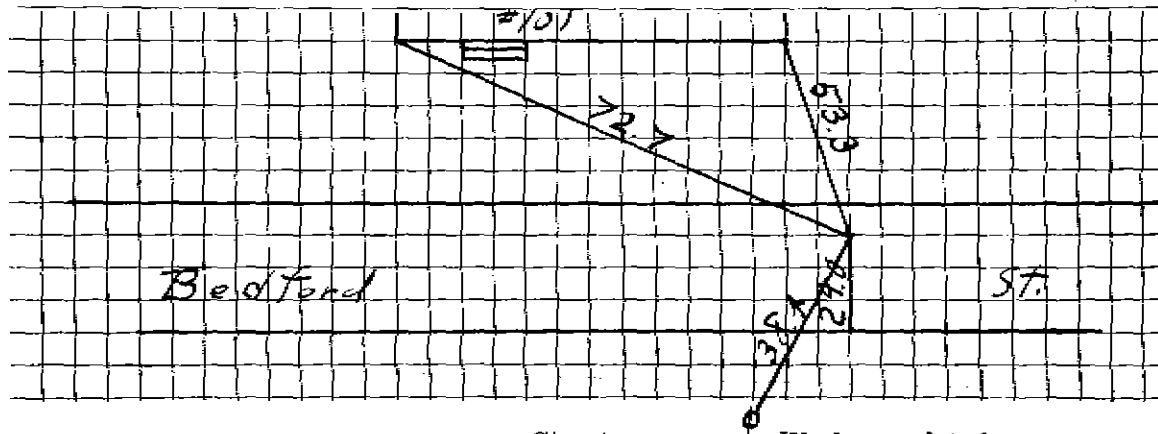

Connection made in Street.

Work completed19

Remarks: