

WATER SERVICE RECORD

Name Salvatore Casella

Service No. 57

Address 104 Bedford St.

2305

Location

~~Repair~~—Renewal—~~New Service~~ W.O. # 9215


APR 20 1971

Date	Material	Amount	Total	Date	Amount
12/1/70	Labor		17 09	11/30/70	Deposit 315 00
10 %	O.H.		1 71	4-20-71	Retrad 165 23
24'	3/4" Copper tubing .79		18 96		49 77
1	3/4 x 1/2 W.H. Stop & Waste		12 01		
			<u>49 77</u>	12/1/70	<u>OUTSIDE</u>
				XXXXXX	Labor 27 47
				33'	3/4" Copper pipe .79 26 07
				1	3/4" Corporation 9 57
				1	3/4" Curb cock 11 32
				1	Box & Rod 5 10
					<u>79 53</u>

DATE _____

TOWN OF LEXINGTON -- BOARD OF PUBLIC WORKS
WATER DIVISION

Sketch of Service Here

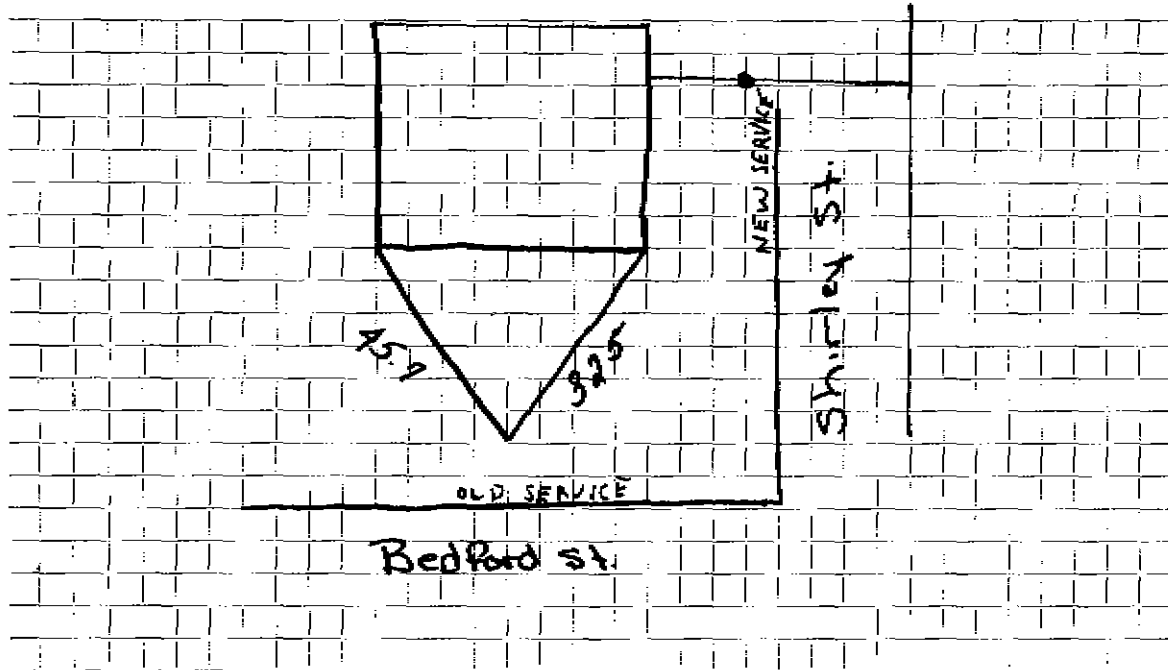

Connection made in Street. Work completed

Remarks:

.....

.....