

Name John Plugis
 Address 105 Bedford Street
 Terminus, Mas.

Service No. 3342
 #6600

Location 105 Bedford Street

Kind of Pipe

Size

Size of Main

~~Repair - Renewal -~~ New Service

Location

Date	Material	Amount	Total	Date	Amount
Aug. 18, '47	Labor	1 05	1 05	Aug 18 '47	45 00
	10% Overhead		11	Sept 25 '47	1 46
	47' - 3/4" Copper Tubing	7.28	13 16		43 54
	1 - 3/4" C x 1/2" I.W.H. S & W	3 15		Aug. 18, '47	47 00
	1 - 3/4" C x 3/4" C Union (3 pts)	1 32		29' - 3/4" Copper Tubing	8 12
	Patching 24' x 3'		24 00	1 - 3/4" C Corp-cock	3 00
	Trucking 1 hr. @ .75		75	1 - 3/4" C x 3/4" C Curb-cock	3 62
			43 54	1 - Box & Rod	4 26
				1 - 3/4" Offset Tail Piece	30
				1 - 3/4" Straight Tail Piece	30
				Compressor 4 hrs. @ 1.75	7 00
				Trucking 1 hr. @ .75	75
	Labor				74 41

Deposited
Refunded
 Non-Charge

TOWN OF LEXINGTON - BOARD OF PUBLIC WORKS
WATER DIVISION

The undersigned applies for a supply of water at No..... St. and hereby agrees to comply with the rules and regulations as now, or at any future time, established by the Board of Selectmen.

Am't of Estimate \$.....


Owner

Am't Paid \$.....

Address 165

Builder

Sketch of Service Here

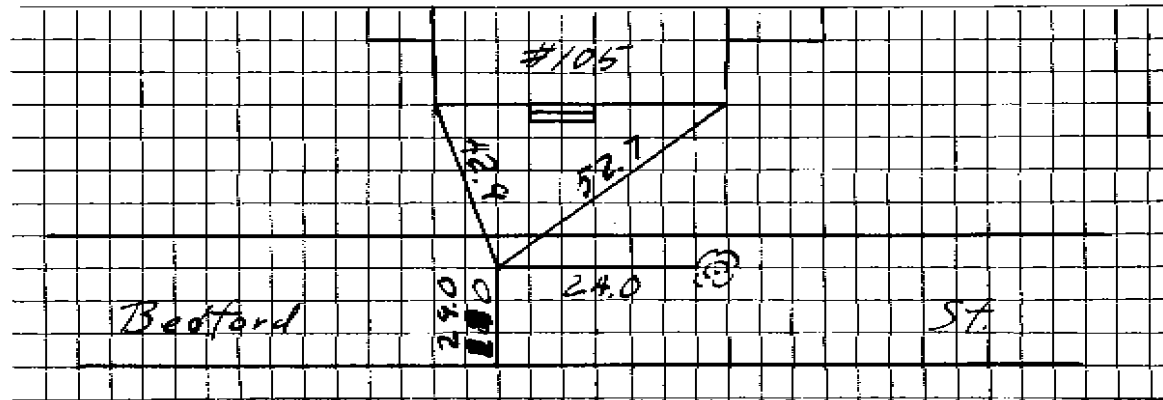

Connection made in Street.

Work completed19

Remarks: