

**WATER SERVICE RECORD**

Name *Ruth E. Turner*

Service No. 70

Address *11 Bedford Street*

Location

~~Repair - Renewal - New Service~~ \* W.O. # 7566

JAN 27 1969


Date	Material	Amount	Total	Date	Amount
11/6/68	Labor		97 36	<i>10-30-68</i>	<i>Deposit</i> 185 00
	10% O.H.		9 74	<i>1-27-69</i>	<i>Refund</i> 9 43
35'	3/4" Copperpipe .79		27 65		175 57
1	3/4" Wheel Valve		9 30		<u>Outside</u>
1	3/4" Copper to iron fitting		1 42	11/6/68	Labor 19 19
1	Yd. Loam		3 50	1 1/4	Hr. Trucking 3.00 3 75
1	Lb. Grass seed		1 10	1/2	" " 1.50 40
2	Hrs. Trucking 3.00		6 00	1/2	" Roller 3.00 1 50
3	" Shovel 6.50		19 50		Trailer 2 00
			175 57		26 84
					<u>RENEWAL - OUTSIDE</u>
				11/21/84 6	3/4" Copper
				1	3/4 Corp.
				1	3/4 Curb
				8	Yds. Gravel
					2 Tons - Cold Patch
					Patch - 12' x 7'
					8' x 5'

DATE \_\_\_\_\_

# TOWN OF LEXINGTON — BOARD OF PUBLIC WORKS

## WATER DIVISION

Sketch of Service Here

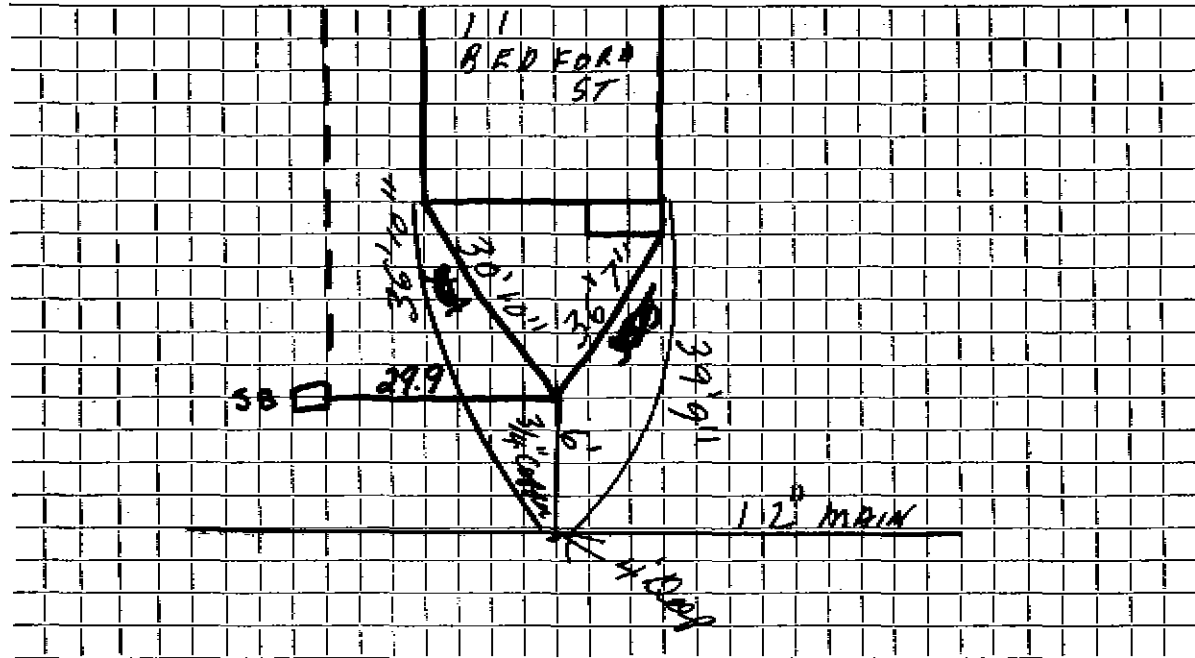

Connection made in ..... Street. Work completed .....

Remarks: .....

.....

.....