

*4447

WATER SERVICE RECORD

Name Mark Moore

Service No. 26

Address 113 Bedford St.

Location

~~Repair - Renewal~~ New Service W.O. # 6540 DeFlice #1401

SEP 2 1969

Date	Material	Amount	Total	Date	Amount
6/30/69	Labor	54 88		1-20-69	100 00
7/14/69	"	20 50		1-2-69	57 19
	10% O.H.	7 54	82 92		157 19
15'	3/4" Copper pipe .79		11 85		
1	3/4" Corporation		9 57		
1	3/4" Curb cock		11 32		
	Box & Rod		5 10		
1/2	Ton cold patch 5.50		1 38		
1	" Hot top		5 80		
3 1/2	Hrs/ Trucking 3.00		10 50		
1/2	" " 1.50		75		
2	" Shovel 6.50		13 00		
1	" Compressor		5 00		
			157 19		
7-10-69	47' 3/4" Copper tubing				


Deposit
Paid by SAC #58

DATE _____

TOWN OF LEXINGTON — BOARD OF PUBLIC WORKS

WATER DIVISION

Sketch of Service Here

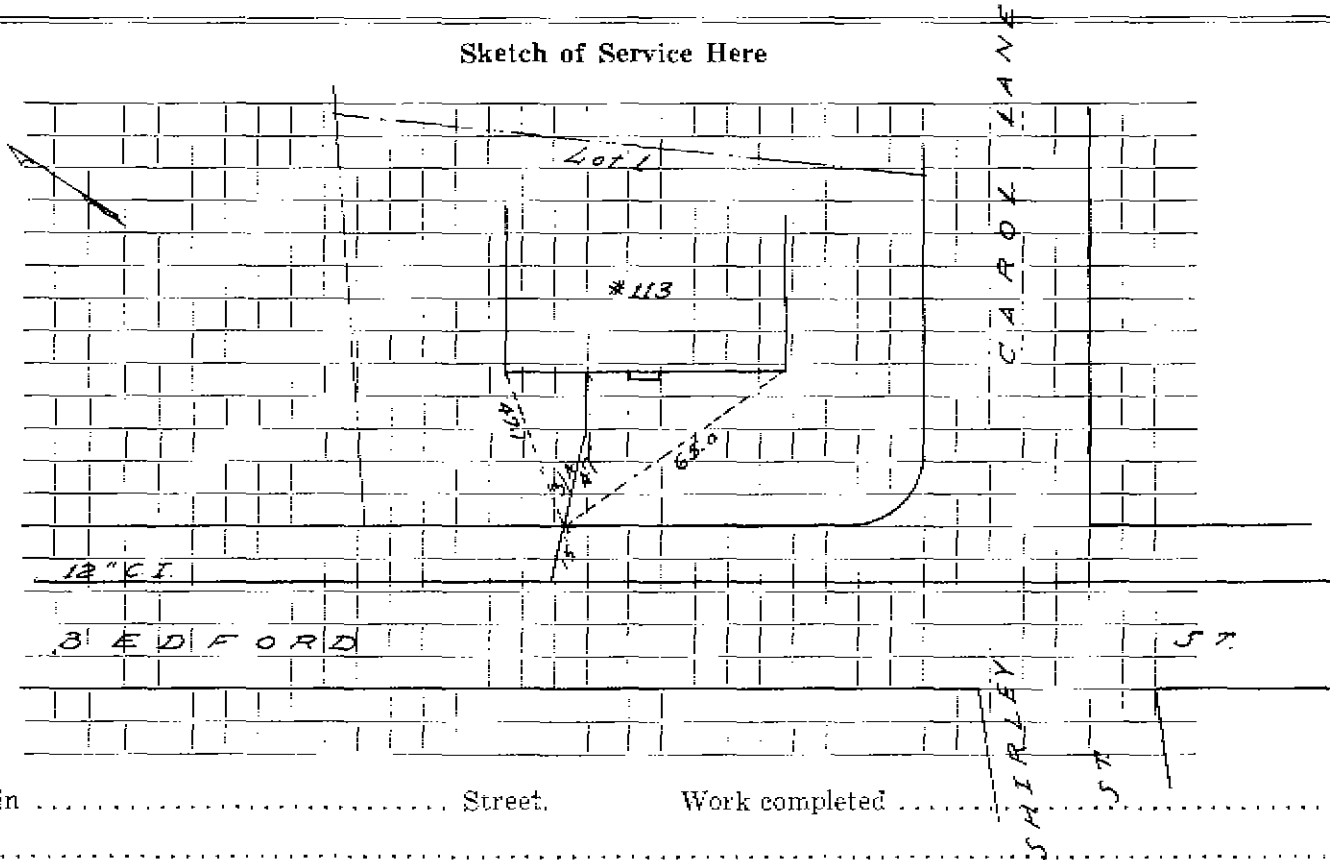

Connection made in Street. Work completed

Remarks:

.....
.....