

Name

Address

Service No. *144*

Location *117 Bedford St.*

Kind of Pipe

Size

Size of Main

Repair—Renewal—New Service

Location

Date	Material	Amount	Total	Date	Location	Amount
	Labor					

Hadley Press, Inc., Lexington

TOWN OF LEXINGTON—BOARD OF PUBLIC WORKS
WATER DIVISION

The undersigned applies for a supply of water at No. _____ St. and hereby agrees to comply with the rules and regulations as now, or at any future time, established by the Board of Selectmen.

Am't. of Estimate \$ _____


Owner A Sorensen

Am't. Paid \$ _____

Address ~~77~~ Bedford St
117

Builder _____

Sketch of Service Here

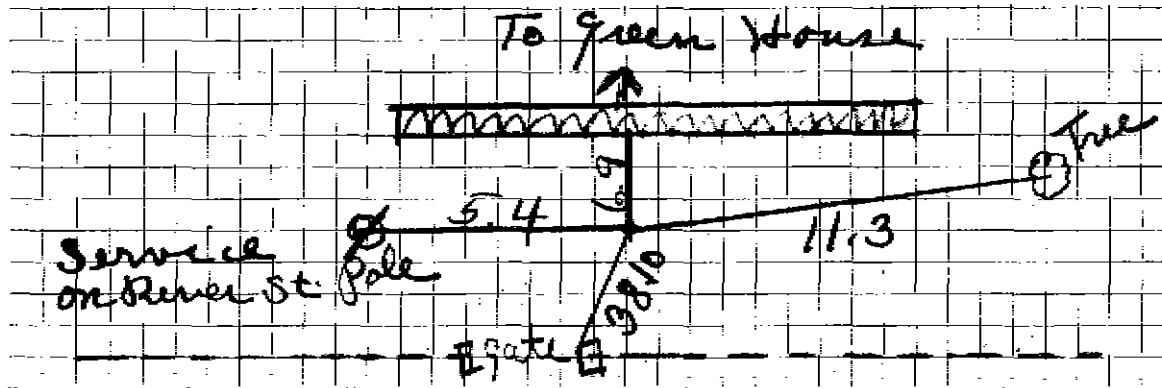

Connection made in _____ Street. Work completed _____ 19

Remarks:

WATER SERVICE RECORD

Name Emanuel Wronski

Service No. 134

Address ~~117 Bedford Street~~ #4 Carol Lane (Changed by Eng. Dept. 10/25/68)

Location Lexington, Mass.

~~Demolition~~ New Service

Billed 12-26-50

Date	Material	Amount	Total	Date	Material	Amount
June 24, '50	Labor	5 10	5 10	June 24, '50	Labor	30 00
	10% Overhead		51			
	Littlefield Shovel 2 hrs. @ 7.00	14 00	14 00		No Charge	46 36
	Trucking 1 hr. @ .75		75	June 24, '50	Labor	30 00
	Patching		25 00		40' - 1" Copper Tubing @ .284	11 36
			45 36		4 - 1" C Corp-cock	18 48
					1 - 1" C x 2" I 4 way Branch	6 00
					1 - 2" L. L. Coupling	1 06
					13" 2" C. L. Pipe @ .73	9 49
					1 - 2" F. H. Gate Valve	10 06
					4' - 36" Clay Pipe	8 00
					Pit Cover & Frame	13 00
					Littlefield Shovel 4 hrs. @ 7.00	28 00
					Trucking 1 hr. @ .75	75
						136 20

Name

Service No. 145

Address

Location 117 Bedford St.

Kind of Pipe

Size

Size of Main

Repair—Renewal—New Service

Location

Date

Material

Amount

Total

Date

Amount

Labor

DATE _____

TOWN OF LEXINGTON—BOARD OF PUBLIC WORKS

WATER DIVISION

The undersigned applies for a supply of water at No. _____ St. and hereby agrees to comply with the rules and regulations as now, or at any future time, established by the Board of Selectmen.

Am't. of Estimate \$ _____


Owner A Sorensen

Am't. Paid \$ _____

Address ~~77~~ Bedford St.
117

Builder _____

Sketch of Service Here

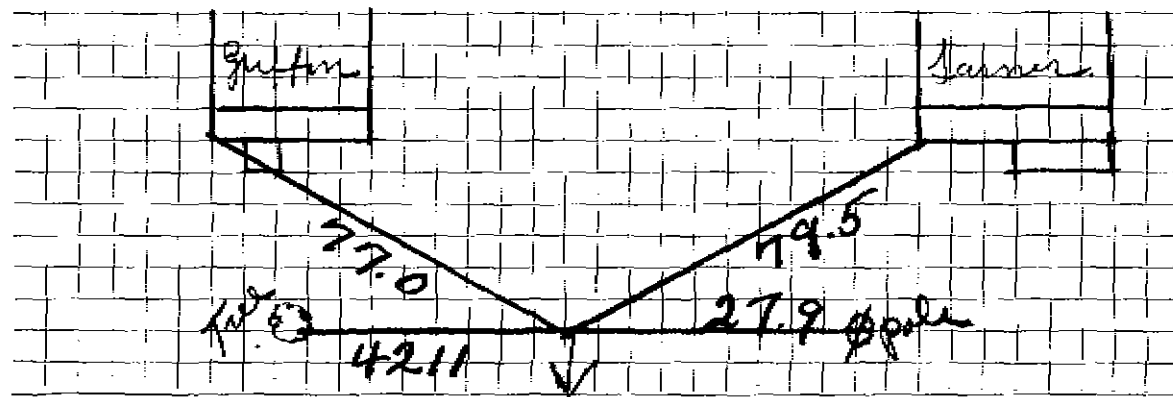

Connection made in _____ To Street. Work completed _____ 19

Remarks: Green House