

WATER SERVICE RECORD

Name

Service No.

Address

12 Bedford Street

Location

Repair - Renewal - New Service

Kind of Pipe - Copper type K. Size - 1", Size of main: 12"


Date	Material	Amount	Total	Date	Material	Amount
9-4-62	35' 3/4" copper			7-24-64	12' 3/4" copper	
	1 3/4" C x 1/2" I.W.H. Stop & waste				1 3/4" curb stop	
				11-1-00	1 1" corporation off 12" main	
					1 1" x 3/4" union (coupling)	
					20' 1" copper BTW 12" main & union	

DATE 11-1-2000

TOWN OF LEXINGTON — BOARD OF PUBLIC WORKS

WATER DIVISION

Sketch of Service Here

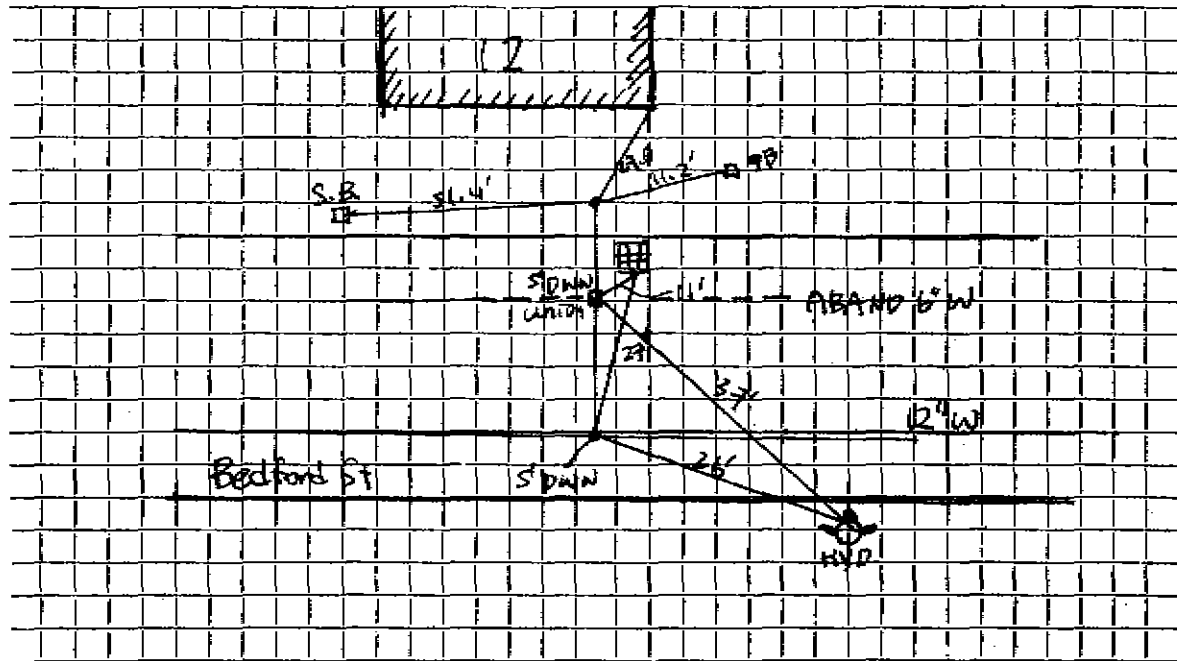

Connection made in Bedford Street (opposite side) Street.

Work completed. Granese & Sons, Inc. (Sub: Defelice)

Remarks:

Contract Coo-12 field book #1. D.F.

WATER SERVICE RECORD

Name **Frank Tobin**

Service No. **118**

Address **12 Bedford Street**

1753

Location

~~Repair~~ ~~Renewal~~ ~~No Service~~ **W.O. #7578**

Comm 10-29-62

Date	Material	Amount	Total	Date	Amount	
8-31-62	Labor	46.22		8-30-62	Deposit	100 00
9-4-62	"	13.08	59.30	7-2-63	Paid	14 10
	10% O.H.	5.93	65.23			114 10
	35' 3/4" Copper tubing @.42		14.70			
	1 3/4" Cx 1/2 I.W.H. Stop & Waste		6.17		CURB TO MAIN RENEWAL	
	3 Hrs. Trucking @3.00		9.00	7/24/64	Labor 59.51	
	2 Hrs. Town Shovel @6.50		13.00		10% O. H. 5.95	65 46
	1 Square Cement		6.00	12'	3/4" Copper tubing @ .42	5 04
			<u>114.10</u>	1	3/4" Corp. cock	7 41
				1	3/4" Curb cock	8 76
					10 x 3 patch	10 00
				2	hrs. Town shoves @ 6.50	13 00
				2	hrs. Town truck @ 3.00	6 00
						<u>115 67</u>


11/11 5.95 14.70

DATE _____

TOWN OF LEXINGTON — BOARD OF PUBLIC WORKS

WATER DIVISION

Sketch of Service Here

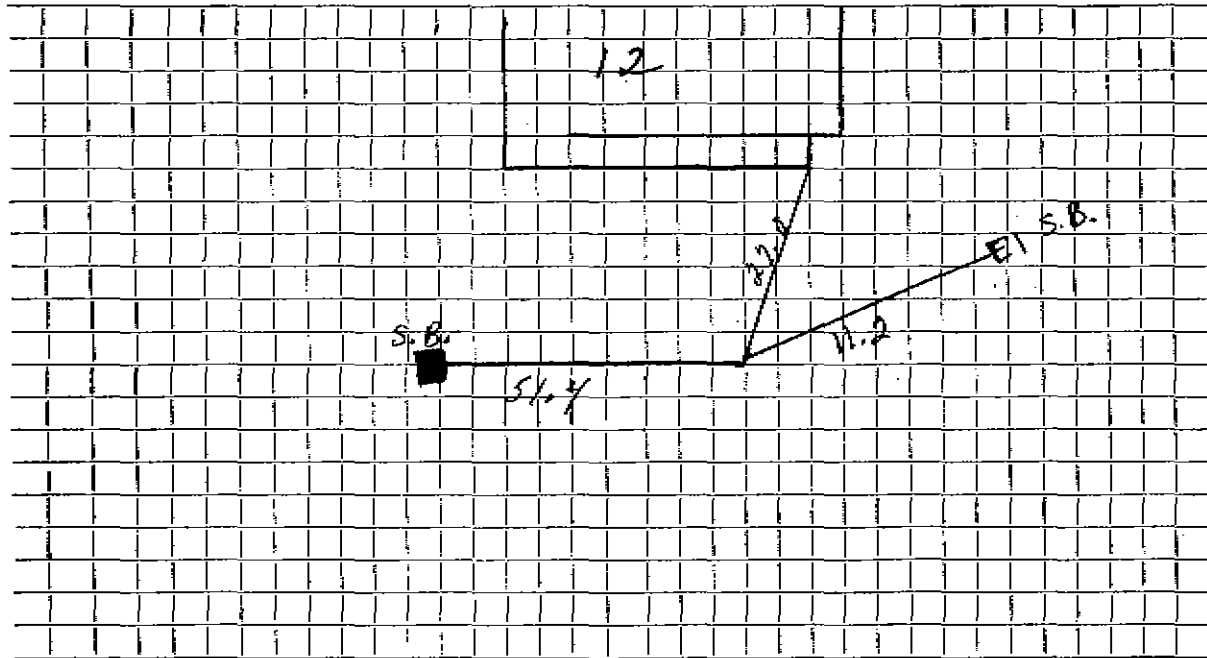

Connection made in Street. Work completed

Remarks: ...*Old Tie*.....

.....
.....