

Service No.

#31

Address 121 Bedford Street  
 Lexington, Mass.

#3937

Location 121 Bedford Street

Kind of Pipe

Size

Size of Main

~~Repair~~ ~~Renewal~~ ~~New Service~~

Com. 8- 23-48

Location

Date	Material	Amount	Total	Date	Amount
June 22, '48	Labor	2 30	2 30	June 19, '48	30 00
	10% Overhead		23	July 20, '48	2 82
	50' - 3/4" Copper tubing @ .255	12 75			22 18
	1 - 3/4" C x 1/2" I.P.F. S & W	3 15		June 21, '48	Labor
	Trucking 1 hr. @ .75	.75		22	"
	catching 3 x 3		3 00	3' - 3/4" Copper tubing @ .255	2 04
			22 28	1 - 3/4" C Sarg-cock	3 00
				1 - 3/4" C x 3/4" C Sarg-cock	3 68
				1 - 1/2" Offset Tail Piece	30
				1 - 1/2" Straight Tail Piece	30
				1 - Box & lid	3 55
				Trucking 1 hr. @ .75	75
					31 87
	Trench dug by owner				
	Labor				

Hadley Press, Inc., Lexington

TOWN OF LEXINGTON—BOARD OF PUBLIC WORKS  
**WATER DIVISION**

The undersigned applies for a supply of water at No. \_\_\_\_\_ St. and hereby agrees to comply with the rules and regulations as now, or at any future time, established by the Board of Selectmen.

Am't. of Estimate \$ \_\_\_\_\_


Owner \_\_\_\_\_

Am't. Paid \$ \_\_\_\_\_

Address \_\_\_\_\_

Builder \_\_\_\_\_

Sketch of Service Here

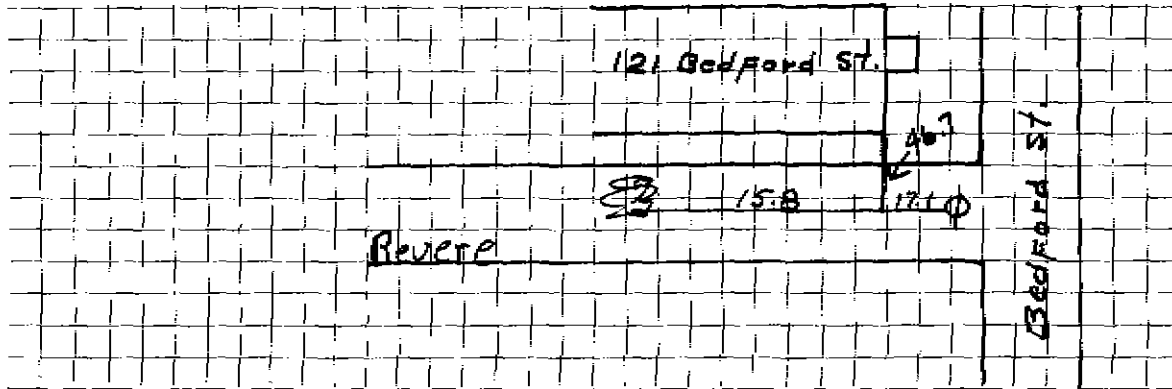

Connection made in \_\_\_\_\_ Street.

Work completed \_\_\_\_\_ 19\_\_

Remarks:

Repair made 12-30-90  
2 comp. 3 part union in side walk one is @ Back side of sidewalk  
the other almost in the middle under Duct line for Control Box