

Name Colonial Building Corp.

Service No. 65 3/66

Address 127 Bedford Street
Lexington, Mass.

Location 127 Bedford Street

Kind of Pipe

Size

Size of Main

~~Repair - Removal -~~ New Service

Com 12-30-46

Location

Date	Material	Amount	Total	Date	Amount
Aug. 8, '46	Labor	2 62	2 62	Jul 22 '46	45 00
	10% Overhead		26	Dec. 31 '46	4 80
	43' - 3/4" Copper Tubing @.1911	8 22	8 22		49 80
	1 - 3/4" C x 3/4" I.W.H. S & W	2 82	2 82	Jul. 23, '46	21 83
	2 - 3/4" C x 3/4" C Unions 3 pts.	2 64	2 64	Jul. 24, '46	6 77
	1 - 3/4" x 1/2" Elbow (Brass)		36	32' - 3/4" Copper Tubing @.1911	6 12
	1 - 3/4" Close Nipple (Brass)		38	1 - 3/4" C Corp-cock	2 70
	Patching 30 x 3		30 00	1 - 3/4" C x 3/4" C Curb-cock	3 30
	Compressor 1 hr. @1.75		1 75	1 - Box & Rod	3 35
	Trucking 1 hr. @.75		75	2 - 1/2" Straight Tail Pieces	1 00
			49 80	Compressor 2 hrs. @1.75	3 50
				Trucking 1 hr. @.75	75
	<u>Trench dug by Owner</u>				
	Labor				49 32

Deposited
Bank

Non-Charge

Hadley Press, Inc., Lexington

DATE _____

TOWN OF LEXINGTON—BOARD OF PUBLIC WORKS WATER DIVISION

The undersigned applies for a supply of water at No. _____ St. and hereby agrees to comply with the rules and regulations as now, or at any future time, established by the Board of Selectmen.


Am't. of Estimate \$ _____

Owner Colonial Building Corp.
by Theodore & Freeman Jones

Am't. Paid \$ _____

Address 7 Cutting St
Winchester

Builder _____

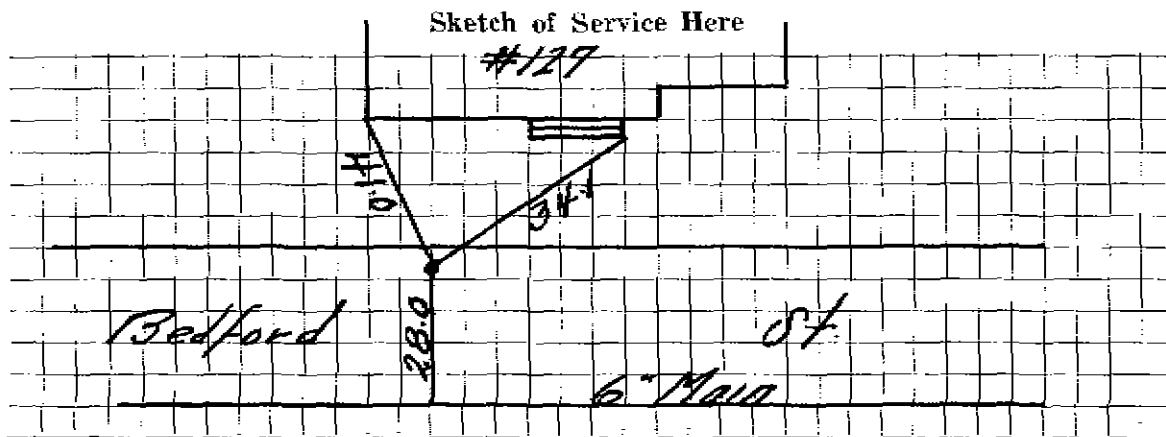

Connection made in _____ Street. Work completed _____ 19__

Remarks: