

Name James S. Robb
 Address 13 Bedford Street

Service No. # 106
 #1957

Location same

Kind of Pipe

Size

Size of Main

~~Report on Repair~~ - New Service

Location

Date
 1937

Material

Amount

Total

Date

Amount

11/2/

44 hrs. @ 55¢

24 20

October 21, 1937 Reported

176 00

Com 12-14-37

18 " @ 60¢

10 80

Refunded

91 66

2 " @ 65¢

1 30

36 30

83 34

10% Overhead

3 63

112' 3/4" Cop. Tub. @ 25¢

28 00

1 3/4" CxI S. & W.

3 75

1 3/4" C. Union 3 part.

1 25

5 hrs. trucking @ 75¢

3 75

Trench Repairs

6 66

\$83 34

Labor

DATE _____

TOWN OF LEXINGTON—BOARD OF PUBLIC WORKS

WATER DIVISION

The undersigned applies for a supply of water at No. 15 1/2 St. and hereby agrees to comply with the rules and regulations as now, or at any future time, established by the Board of Selectmen.

Am't. of Estimate \$ 1000

Owner

James S. Robb


Am't. Paid \$ _____

Address

13 Bedford St

Builder _____

Sketch of Service Here

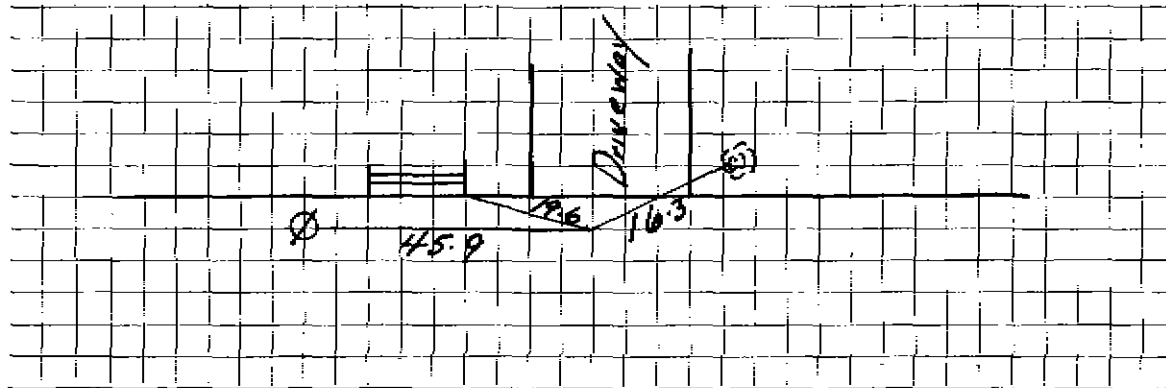

Connection made in _____ Street.

Work completed _____ 19

Remarks: