

WATER SERVICE RECORD

Name

Service No. 313 (1951)

Address

130 BEDFORD ST

Location

LEXINGTON


Repair—Renewal—New Service

Date		Material	Amount	Total	Date		outside	Amount
		INSIDE			3-18	52		
3-18	52	52' 3/4 COPPER					10' 3/4 COPPER	
		1-3/4" C x 1/2" I W/ STOP + WASTE					1-3/4 CORP	
							1-3/4 CURB	
							1 BOX + ROD	
							1-1/2 OFFSET TAIL PIECE	
							1-1/2 STRAIGHT TAIL PIECE	
							CHARGE TO 1" 2000	
							1" X 3/4 UNION	

DATE \_\_\_\_\_

**TOWN OF LEXINGTON — BOARD OF PUBLIC WORKS**  
**WATER DIVISION**

Sketch of Service Here

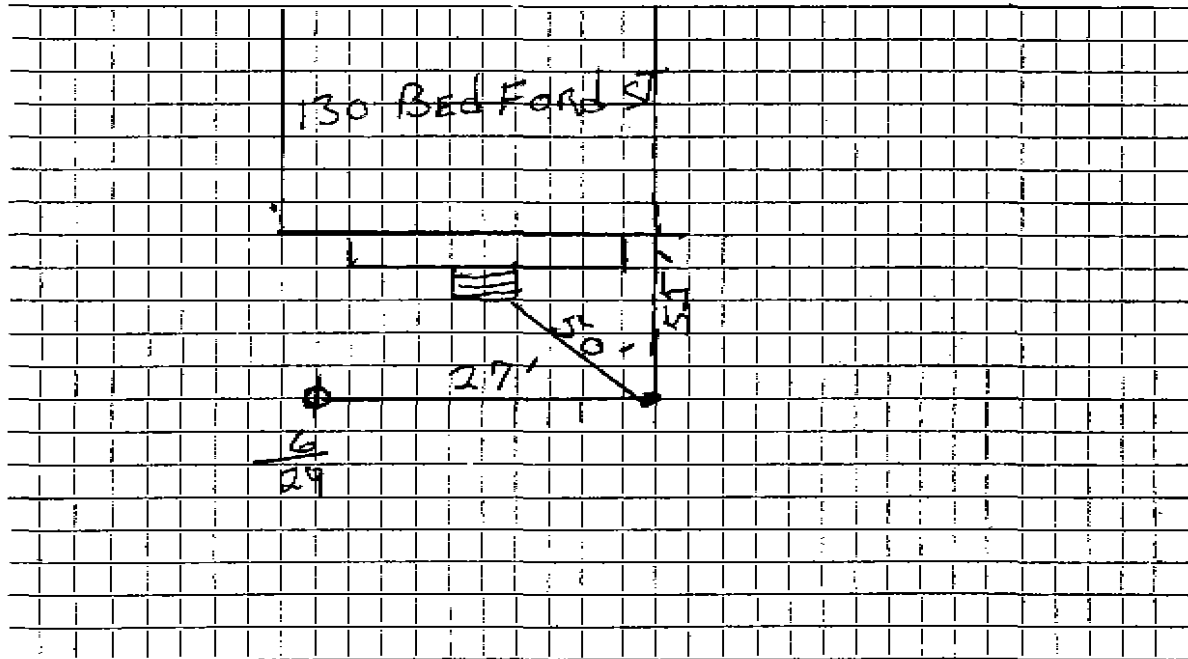

Connection made in ..... Street. Work completed .....

Remarks: .....  
.....  
.....