

Name Colonial Building Corporation

Service No. 65 3/65

Address 133 Bedford Street

Lexington, Mass.

Location 133 Bedford Street

Kind of Pipe

Size

Size of Main

~~Repair - Renewal~~ - New Service

Com 12 30-46

Location

Date	Material	Amount	Total	Date		Amount
Aug. 18, '46	Labor	2 62	2 62	<i>Jul 22 46</i>	<i>Repaired and No-Charge</i>	45 00
	10% Overhead		26	<i>Jan 14 47</i>		9 98
	74' - 3/4" Copper Tubing @.1911		14 14			54 98
	1 - 3/4" C x 1/2" I.W.H. S & W		2 82	May 27, '46	Labor	33 81
	2 - 3/4" C x 1/2" C Unions (3 parts)		2 64	29 46	"	8 78
	Patching 30 x 3		30 00	32' - 3/4" Copper Tubing @.1911		6 12
	Compressor 1 hr. @1.75		1 75	1 - 1/4" C Corp-cock		2 70
	Trucking 1 hr. @.75		75	1 - 3/4" C x 1/2" C Curb-cock		3 30
			54 98	1 - Box & Rod		3 35
	<u>Trench Dug By Owner</u>			1 - 1/2" Offset Tail Piece		50
				1 - 1/2" Straight Tail Piece		50
				Compressor 2 hrs. @1.75		3 50
	Labor			Trucking 2 hrs. @.75		1 50
						64 06

TOWN OF LEXINGTON—BOARD OF PUBLIC WORKS WATER DIVISION

The undersigned applies for a supply of water at No. _____ St. and hereby agrees to comply with the rules and regulations as now, or at any future time, established by the Board of Selectmen.

Am't. of Estimate \$ _____

Owner

Colonial Building Corp.
47 Madison & Freeman Pkwy


Am't. Paid \$ _____

Address

7 Cutty St.

Builder _____

Worcester

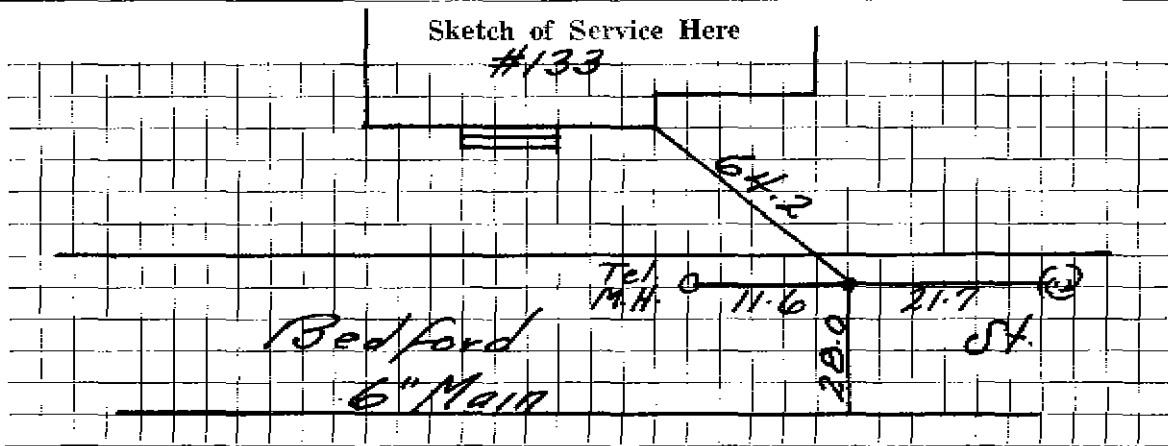

Connection made in _____ Street. Work completed _____ 19__

Remarks: