

WATER SERVICE RECORD

2769

Name William Kiniklis

Service No. 229 n.d.

Address 134 Bedford St.

Location

Repair-Renewal-~~New Service~~

*Com. 9-13-54*

Date	Material	Amount	Total	Date	Amount
8/5/54	Labor	2 00			
	10% overhead	20	2 20		
	60' - 3/4" copper tubing@.35		21 00	9-13-54	27 95
	1 - 3/4"C x 1/2" I.W.F. stop & waste	4 00			
	1 hr. trucking		75		
			27 95		
				8/5/54	2 00
				12' - 3/4" copper tubing@.35	4 20
				1 - 3/4"C. corp-cock	4 33
				1 - 3/4"C curb-cock	4 67
				1 box anr rod	3 90
				1 - 1/8" straight tail pc.	50
				1 - 1/8" offset tail pc.	50
				1 hr. trucking	75
					20 85

*No deposit  
Paid*


NON CHARGE

DATE \_\_\_\_\_

TOWN OF LEXINGTON — BOARD OF PUBLIC WORKS

**WATER DIVISION**

Sketch of Service Here

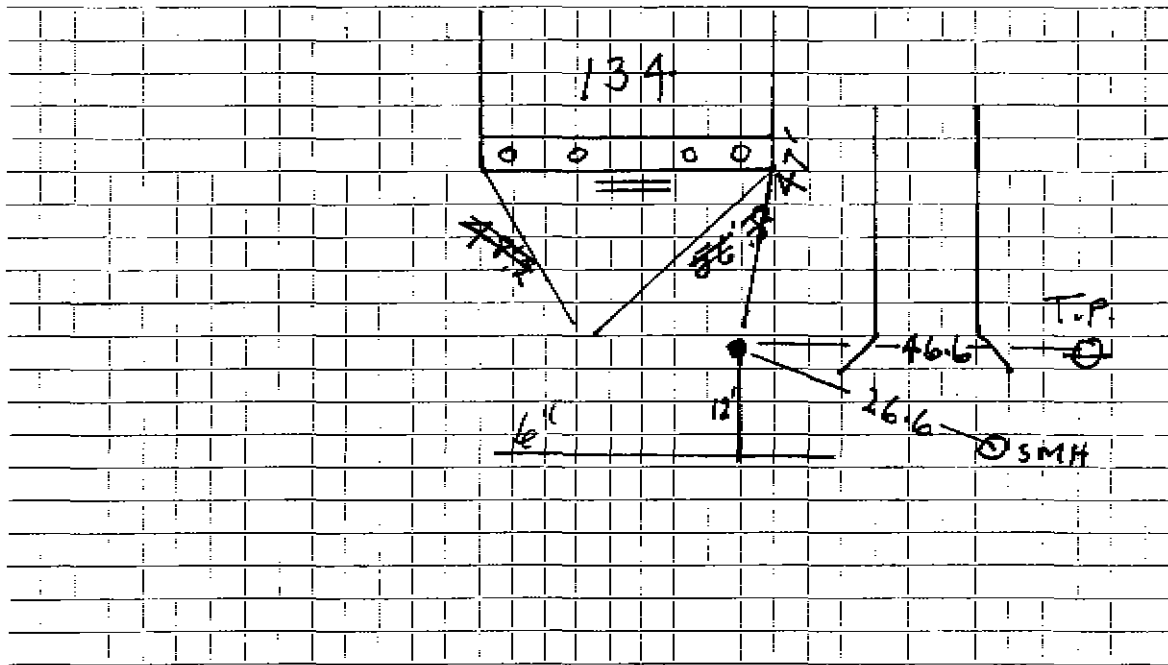

Connection made in ..... Street. Work completed .....

Remarks: .....

.....

.....