

WATER SERVICE RECORD

11/15/72

Name Edward M. Mahoney

Service No. 33

Address 136 Bedford Street

Location

~~Repair~~—Renewal—~~New Service~~
~~XXXXXX~~ W. O. # 8159

JAN 17 1972


Date	Material	Amount	Total	Date	Amount
9/30/71	Labor	54 45		<i>12-17-72</i>	<i>Deposit</i> 125 00
	10% O.H.	5 45	59 90	<i>1-17-72</i>	<i>Refund</i> .57 63
	36' 3/4" Copper pipe .79		28 44		117 37
	1 3/4" Wheel Valve		12 53		
	1 5/8" Tailpiece		50		
	2 Hrs. Shovel 6.50		13 00	9/30/71	OUTSIDE Labor 63 78
	1 Hr. Trucking		3 00	13'	3/4" Copper pipe .79 10 27
			117 37	1	3/4" Curb Stop 11 32
				1	Adaptor 2 76
				1	Ton Cold Patch 8 00
				1 1/2	" Trucking 3.00 3 75
				1/2	" Compressor 3.00 1 50
				1	" Roller 2 00
					103 38

DATE _____

TOWN OF LEXINGTON — BOARD OF PUBLIC WORKS

WATER DIVISION

Sketch of Service Here

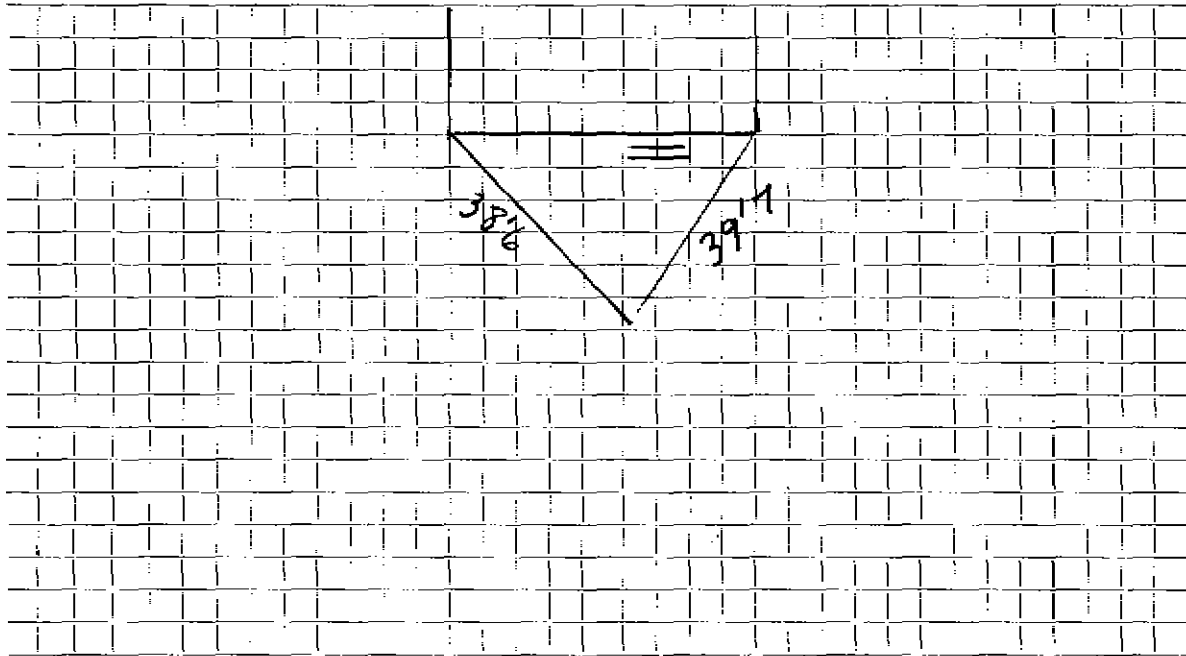

Connection made in Street. Work completed

Remarks:
.....
.....