

Name Theodore Freeman

H 2800

Service No. 23 3116

Address 7 Cutting Street, Winchester
139 Bedford Street

Location 139 Bedford Street

Kind of Pipe

Size

Size of Main

~~Repair~~ ~~Renewal~~ — New Service

Com 9-16-46

Location

Date	Material	Amount	Total	Date	Amount
Apr. 27 '46	Labor	10 80	10 80	April 23 '46	45 00
	10% overhead		1 08	Oct. 3 '46	11 93
	52'-3/4" copper tubing		9 44		56 93
	1-3/4" Cx3/4" I.Y. Stop & Waste		2 82		
	1-3/4" C. Union (3 parts)		1 04	Apr. 26 '46	6 39
	Patching 6lx3		31 00	27 '46	33 89
	1 hr. trucking		75		
			56 93		
	Labor				
				31'-3/4" copper tubing	5 63
				1-3/4" c. corp-cock	2 70
				1-3/4" c. curb-cock	3 30
				1-box and rod	1 65
				1-3/4" offset tail piece	90
				1-3/4" straight " "	90
				3 hrs. compressor	5 25
				1 hr. trucking	75
					61 36

Hudley Press, Inc., Lexington

DATE _____

TOWN OF LEXINGTON—BOARD OF PUBLIC WORKS

WATER DIVISION

The undersigned applies for a supply of water at No. _____ St. and hereby agrees to comply with the rules and regulations as now, or at any future time, established by the Board of Selectmen.

Am't. of Estimate \$ _____

Owner


Colonial Building Corp
by Sheldon L. Freeman Pres.

Am't. Paid \$ _____

Address

7 Cutting St
Worcester

Builder _____

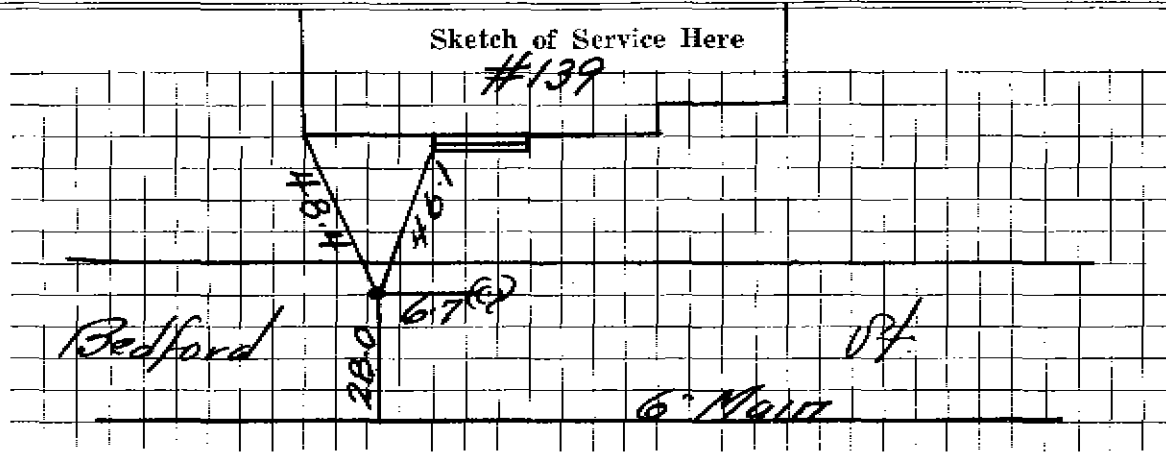

Connection made in _____ Street. Work completed _____ 19

Remarks: