

WATER SERVICE RECORD

Name

Service No.

Address 14-16 Bedford Street

Location

Repair ~~Renewal~~ New Service


Kind of Pipe: Copper/typek Size: 1". Main: 12"

Date		Material	Amount		Total	Date		Material	Amount	
12/21/84	15'	1" copper				12/21/84	2d	1" copper		
							1	1" curb		
							1	curb box & rod		
						11/1/2000	1	1" corporation off 12" main		
							1	1" union (coupling)		
							20"	1" copper BTW 12" main & union		

DATE 11-1-2000

TOWN OF LEXINGTON — BOARD OF PUBLIC WORKS
WATER DIVISION

Sketch of Service Here

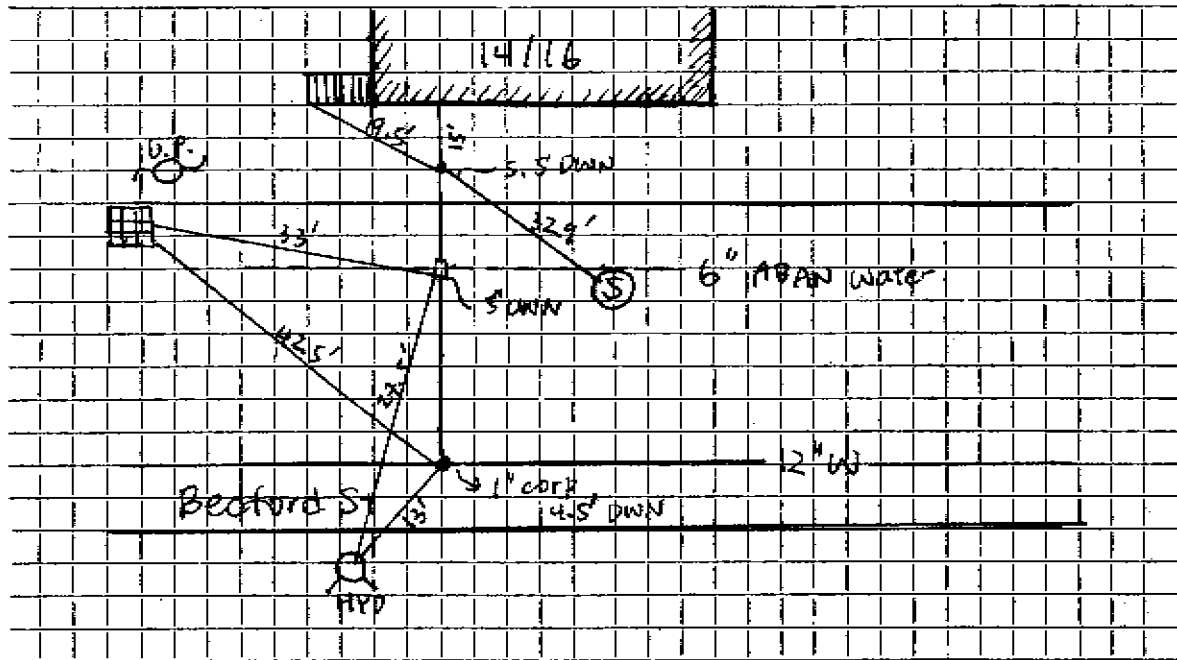

Connection made in Bedford St. (Opposite S. de) Street.

Work completed Graneser & Sons, Inc. (Sub: detelive)

Remarks:

..... 1" corporation off 12" main

..... Contract: C00-12 field book #1 D&I 2000

