

WATER SERVICE RECORD

2723

Name Doris B. Senter

Service No30

Address 142 Bedford St.

Location

Repair - Renewal ~~NEW SERVICE~~ W.O. # 5627

SEP 22 1969


Date	Material	Amount	Total	Date	Amount
7/21/69	Labor		52 20	7-16-69	210 00
	10% O.H.		5 22	9-22-69	96 20
25'	3/4" Copper pipe .79		19 75		113 80
	3/4" - 1/2" Stop & Waste		11 13		
2	Yds. Loam 3.50		7 00		OUTSIDE
2	Hrs. Shovel 6.50		13 00	7/21/69	Labor 31 32
1	" Trucking		3 00	7/22/69	" 33 60
	" Compressor 5.00		2 50	9/27/69	" 29 80
			113 80	20'	3/4" copper pipe .79 15 80
				1	3/4" curb stop-Box & rod 11 32
					5 10
					3/4" Corp. adaptor 2 76
					3/4 Union 3 pt. 3 05
				1	Ton hot top 5 80
				2	Hrs. Shovel 4.00 8 00
				3	" Trucking 3.00 9 00
				1 1/2	" " 1.50 75
				1 1/2	" Compressor 3.00 4 50
				1 1/2	" Roller 3.00 2 50
					Trailer 2 00
					164 30

DATE \_\_\_\_\_

TOWN OF LEXINGTON BOARD OF PUBLIC WORKS

WATER DIVISION

Sketch of Service Here

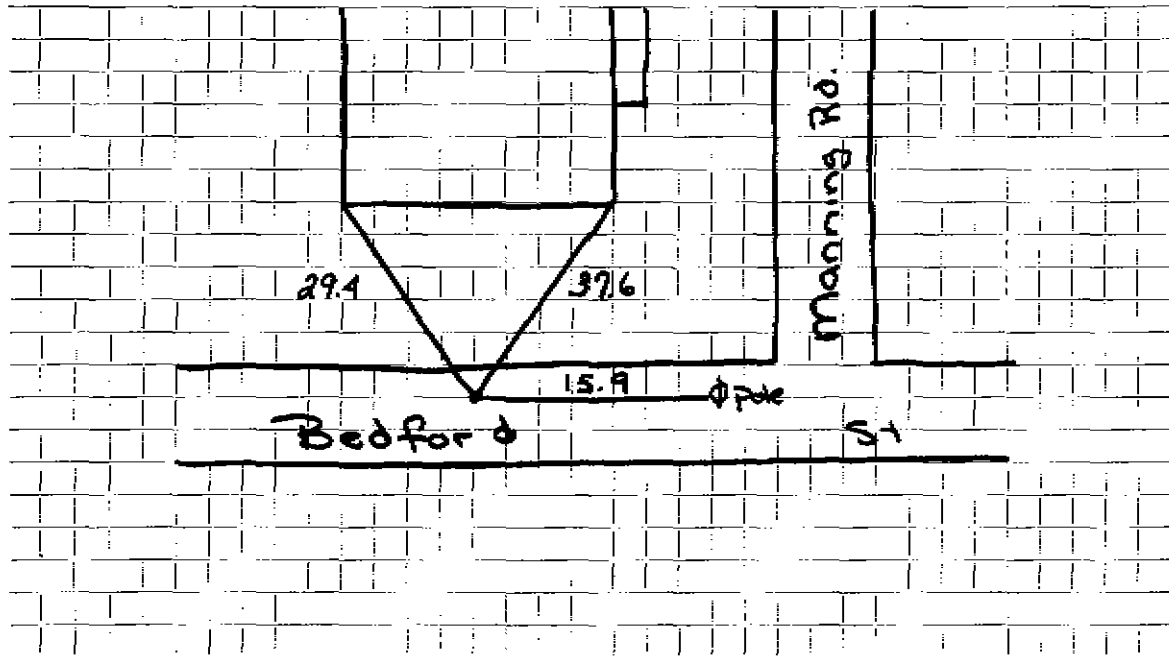

Connection made in ..... Street. Work completed .....

Remarks: .....

.....

.....