

Name Colonial Building Corp.

1436 Service No. 65 3/62

Address 143 Bedford Street

Lexington, Mass.

Location 143 Bedford Street

Kind of Pipe

Size

Size of Main

~~Repair - Renewal~~ - New Service

Com 12-30-46

Location

Date	Material	Amount	Total	Date		Amount
Aug. 3, '46	Labor	1 80	1 80	<i>Jul 22 '46</i>	<i>Deposited</i>	<i>45 00</i>
	10% Overhead		18	<i>Dec 31 '46</i>	<i>Card</i>	<i>2 34</i>
	44' - 3/4" Copper Tubing @.1911	8 41	8 41		Non-Charge	<i>47 34</i>
	1 - 3/4" C x 3/4" I.W.H. S & W	2 82	2 82	Jul. 31, '46	Labor	8 60
	1 - 3/4" C x 3/4" C Union (3 parts)	1 32	1 32	Aug. 12, '46	"	8 85
	1 - 3/4" x 1/2" Red. Bushing		31	29' - 3/4" Copper Tubing @.1911		5 54
	Patching 30' x 3'		30 00	1 - 3/4" C Corp-cock		2 70
	Compressor 1 hr. @1.75		1 75	1 - Box & Rod		3 35
	Trucking 1 hr. @.75		75	1 - 3/4" C x 3/4" C Curb-cock		3 30
			47 34	1 - 1/2" Straight Tail Piece		50
	<u>Trench Dug By Owner</u>			Compressor 2 hrs. @1.75		3 50
				Trucking 1 hr. @.75		75
	Labor					<u>37 09</u>

Hadley Press, Inc., Lexington

TOWN OF LEXINGTON—BOARD OF PUBLIC WORKS

WATER DIVISION

The undersigned applies for a supply of water at No. _____ St. and hereby agrees to comply with the rules and regulations as now, or at any future time, established by the Board of Selectmen.

Am't. of Estimate \$ _____


Owner _____

Am't. Paid \$ _____

Address _____

Builder _____

Sketch of Service Here

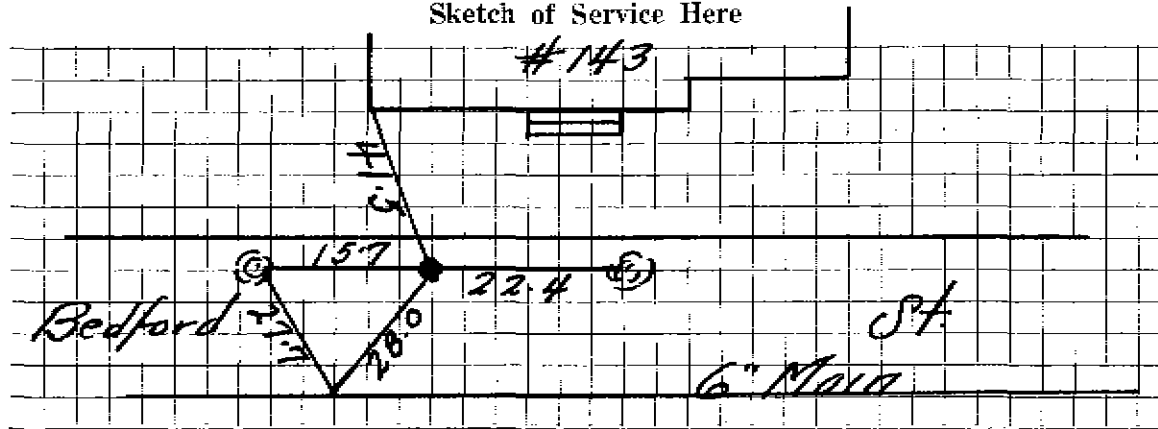

Connection made in _____ Street.

Work completed _____ 19

Remarks: