

WATER SERVICE RECORD

2044
Service No. 66

Name M. Esther Smith

Address 148 Bedford Street

Location

~~REPAIR~~ - Renewal - ~~NEW SERVICE~~ W.O. #3216


Comm 5-8-67

Date	Material	Amount	Total	Date		Amount
10-6-66	Labor	64.50		4-8-66	Deposit	125.00
	10% O.H.	6.45	70.95	5-18-67	Paid	19.24
36'	3/4" Copper tubing @.79		28.44			14.42
1	3/4" Wheel Valve		9.30			
2	yds. Loam @3.00		6.00			
1	lb. Grass Seed		1.05	4/3/64	OUTSIDE Labor	75.79
3	hrs. Trucking @3.00		9.00	14'	3/4" Copper tubing @ .42	5.88
3	hrs. Tractor @6.50		19.50	1	3/4" C adapter	1.62
			144.24	1	3/4" Curb Cock	6.28
				1	1" Style 38 Clamp	2.05
				1	1" L Lined Coupling	60
				1	1 x 4 C.L. Nipple	28
				1	Box and rod	4.90
				1	hr. Town Shoves @ 6.50	6.50
				3	hrs. Trucking @ 3.00	9.00
				6	x 3 Patch	6.00
						118.90
				4/3/64	damage by telephone	

DATE _____

TOWN OF LEXINGTON — BOARD OF PUBLIC WORKS
WATER DIVISION

Sketch of Service Here

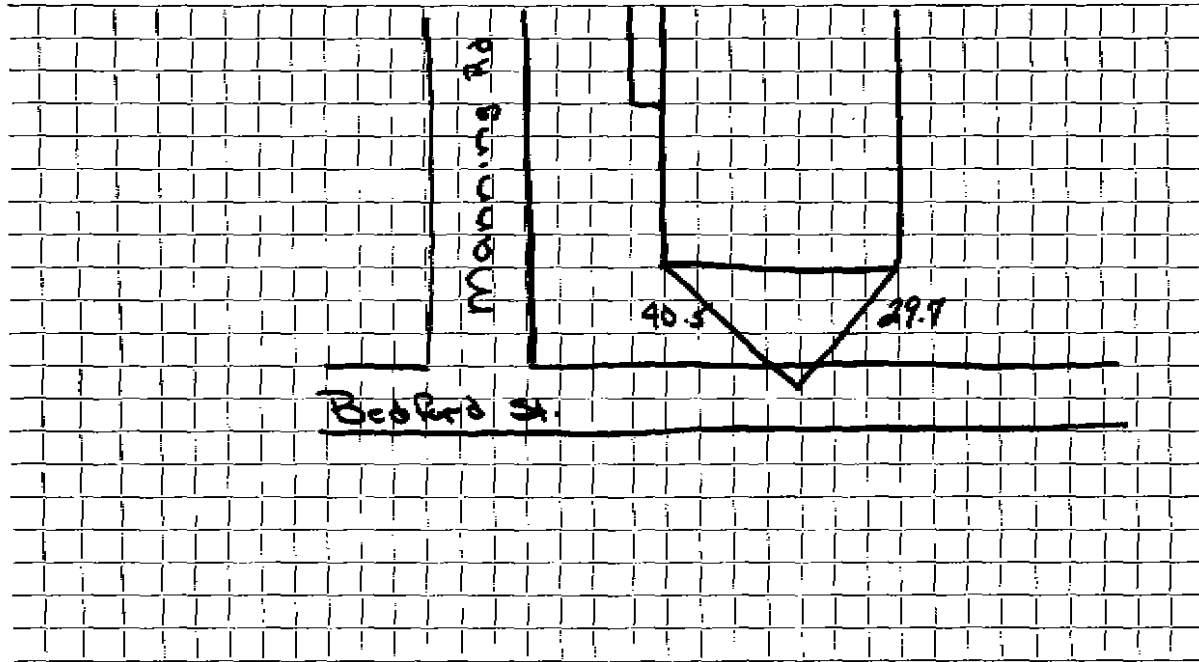

Connection made in Street. Work completed

Remarks:
.....
.....