

Name Colonial Building Corp.

Service No. 65 3163
#5987

Address 149 Bedford Street

Lexington, Mass.

Location 149 Bedford Street

Kind of Pipe

Size

Size of Main

~~Repair - Renewal~~ - New Service

Com 12-30-46

Location

Date	Material	Amount	Total	Date	Location	Amount
Jul. 3, '46	Labor	1 80	1 80	Jul 22 '46	Deposited Card Non-Charge	45 00
	10% Overhead		18	Jan. 14 '47		1 00
	44' - 3/4" Copper Tubing @.1911		8 41			46 03
	1 - 3/8" C x 1/2" I.W.H. S & W		2 82	May 24, '46	Labor	28 25
	1 - 3/8" C x 3/4" C Union (3 parts)		1 32		30' - 3/4" Copper Tubing @.1911	5 73
	Patching 29' x 3'		29 00		1 - 3/4" C Corp-cock	2 70
	Compressor 1 hr. @1.75		1 75		1 - 3/4" C x 3/4" C Curb-cock	3 30
	Trucking 1 hr. @.75		75		1 - Box & Rod	3 35
			46 03		1 - 1/2" Straight Tail Piece	50
	Trench dug By Owner				1 - 1/2" Offset Tail Piece	50
					Compressor 2 hrs. @.1.75	3 50
	Labor				Trucking 1 hr. @.75	75
						48 58

Hadley Press, Inc., Lexington

DATE _____

TOWN OF LEXINGTON—BOARD OF PUBLIC WORKS

WATER DIVISION

The undersigned applies for a supply of water at No. _____ St. and hereby agrees to comply with the rules and regulations as now, or at any future time, established by the Board of Selectmen.

Am't. of Estimate \$ _____

Owner

*Colonial Building Corp.
by Sheldon G. Freeman, Pres*


Am't. Paid \$ _____

Address

7 Cutting St.

Builder _____

Winchester

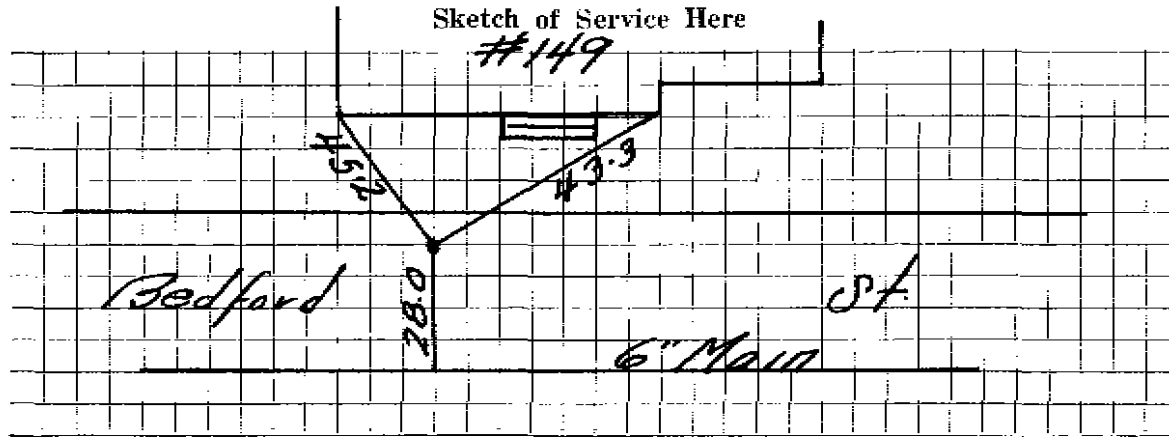

Connection made in _____ Street.

Work completed _____ 19

Remarks: