

Name Eugene H. Partridge

Service No. 62/108

Address 1709 Mass. Avenue, Lexington
15-17 Bedford St.

Location 15-17 Bedford Street

Kind of Pipe

Size

Size of Main

Repair—Renewal—New Service

Location

Date	Material	Amount	Total	Date	Amount
1938					
Nov. 28,	5 hrs. @ 50¢	2 50		Nov. 29, 1938	50 00
<i>Jan 12 1938</i>	25 " 55¢	13 75		Deposited	
	6 " 60¢	3 60			
	1 " 65¢	65			
	3 " 70¢	3 50	24 00		
	10% Overhead		2 40		
	30' 3/4" Cop. Tub.	3 20¢	1 20		
	1 3/4" S. & W.		3 75		
	1 hr. compressor	3 00	3 00		
	2 hrs. trucking	1 75	1 50		
	Patching				
	Flat Rate: \$50.00				
	Labor				

Hadley Press, Inc., Lexington

DATE _____

TOWN OF LEXINGTON—BOARD OF PUBLIC WORKS

WATER DIVISION

The undersigned applies for a supply of water at No. _____ St. and hereby agrees to comply with the rules and regulations as now, or at any future time, established by the Board of Selectmen.

Am't. of Estimate \$ _____


Owner _____

Am't. Paid \$ _____

Address _____

Builder _____

Sketch of Service Here

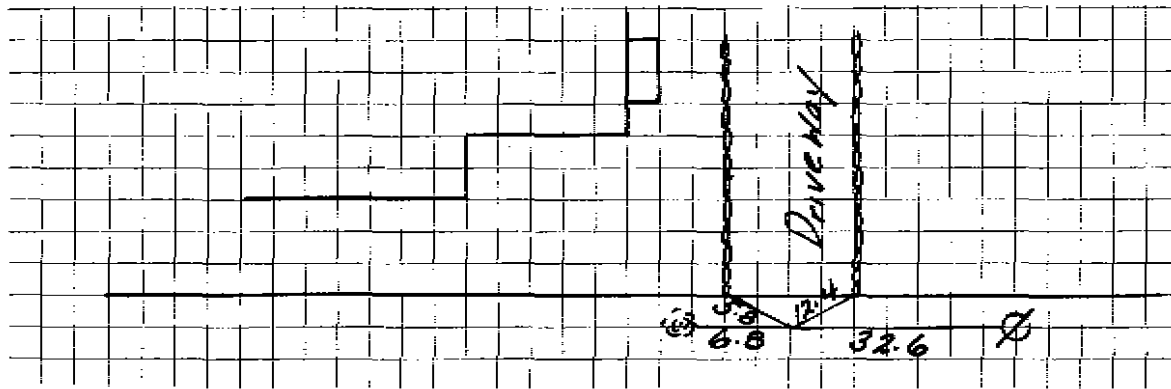

Connection made in _____ Street.

Work completed _____ 19__

Remarks: