

WATER SERVICE RECORD

Name

Service No.

Address

152 Bedford Street

Location

Repair—Renewal—New Service


Date	Material	Amount	Total	Date		Amount
					OUTSIDE	
				7/21/86	9'6" 3/4" Copper	
				1	3/4" LF Adapter	
				1	3/4" Curb	
				1	1" x 3/4" Iron to Copper Ad.	
				1	3/4" Style 138	
				1	1" x 6" CL Nipple	
				1	Box & Rod	
				1 1/2	yds. Cold Patch	
				36	yds. Gravel	

DATE _____

TOWN OF LEXINGTON — BOARD OF PUBLIC WORKS

WATER DIVISION

Sketch of Service Here

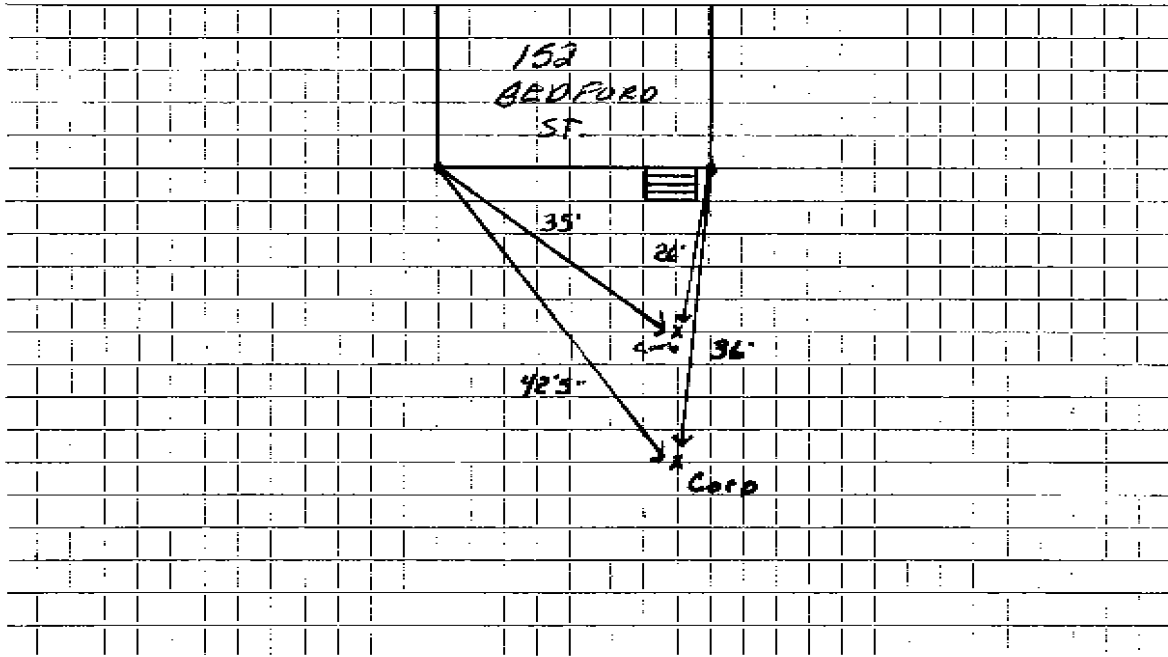

Connection made in Street. Work completed

Remarks:
.....
.....