

Name Colonial Building Corp.

Service No. 65 3161

Address 155 Bedford Street

3903

Lexington, Mass.

Location 155 Bedford Street

Kind of Pipe

Size

Size of Main

~~Repair - Renewal - New Service~~

Com 12-30-46

Location

Date	Material	Amount	Total	Date	Location	Amount
Jul. 3, '46	Labor	1 80	1 80	<i>Jul 22 46</i>	<i>Deposited Cash</i>	45 00
	10% Overhead		18	<i>Dec 31 46</i>		3 53
	45' - 3/4" Copper Tubing @.1911	8 60			Non-Charge	48 53
	1 - 3/4" C x 3/4" I.W.H. S & W	2 82		May 27, '46	Labor	34 42
	1 - 3/4" C x 3/4" C Union 3 pts.	1 32		May 29, '46	"	13 36
	1 - 3/4" x 1/2" Red. Bushing		31	32' - 3/4" Copper Tubing @.1911		6 12
	Patching 31 x 3		31 00	1 - 3/4" C Corp-cock		2 70
	Compressor 1 hr. @1.75		1 75	1 - 3/4" C x 3/4" C Curb-cock		3 30
	Trucking 1 hr. @.75		75	1 - Box & Rod		3 35
			48 53	1 - 1/2" Straight Tail Piece		50
	<u>Trench dug by Owner</u>			1 - 1/2" Offset Tail Piece		50
				Compressor 2 hrs. @1.75		3 50
	Labor			Trucking 2 hrs. @.75		1 50
						69 25

TOWN OF LEXINGTON — BOARD OF PUBLIC WORKS

WATER DIVISION

The undersigned applies for a supply of water at No. _____ St. and hereby agrees to comply with the rules and regulations as now, or at any future time, established by the Board of Selectmen.

Am't. of Estimate \$ _____

Owner


*Colonial Building Corporation
by Theodore H. Freeman Pres.*

Am't. Paid \$ _____

Address

*7 Cutting St.
Worcester*

Builder _____

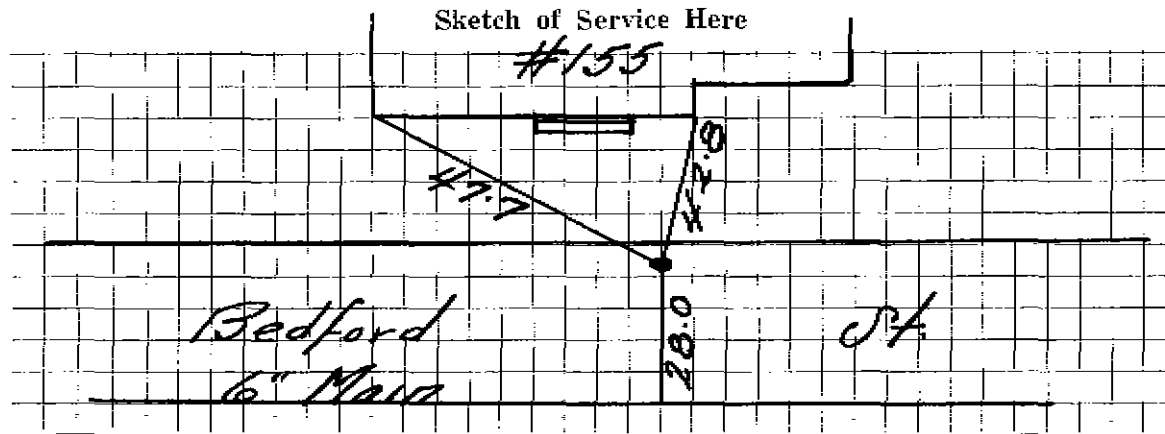

Connection made in _____ Street.

Work completed _____ 19

Remarks: