

Name

Service No. 155

Address 169 Bedford St.

Location 169 Bedford St.

Kind of Pipe

Size

Size of Main

Repair—Renewal—New Service

Location

Date

Material

Amount

Total

Date

Amount

6" Sprinkler

Labor

DATE _____

TOWN OF LEXINGTON—BOARD OF PUBLIC WORKS

WATER DIVISION

The undersigned applies for a supply of water at No. _____ St. and hereby agrees to comply with the rules and regulations as now, or at any future time, established by the Board of Selectmen.

Am't. of Estimate \$ _____

Owner _____

Middle Boston St. B'y.


Am't. Paid \$ _____

Address _____

169 Bedford St.

Builder _____

Sketch of Service Here

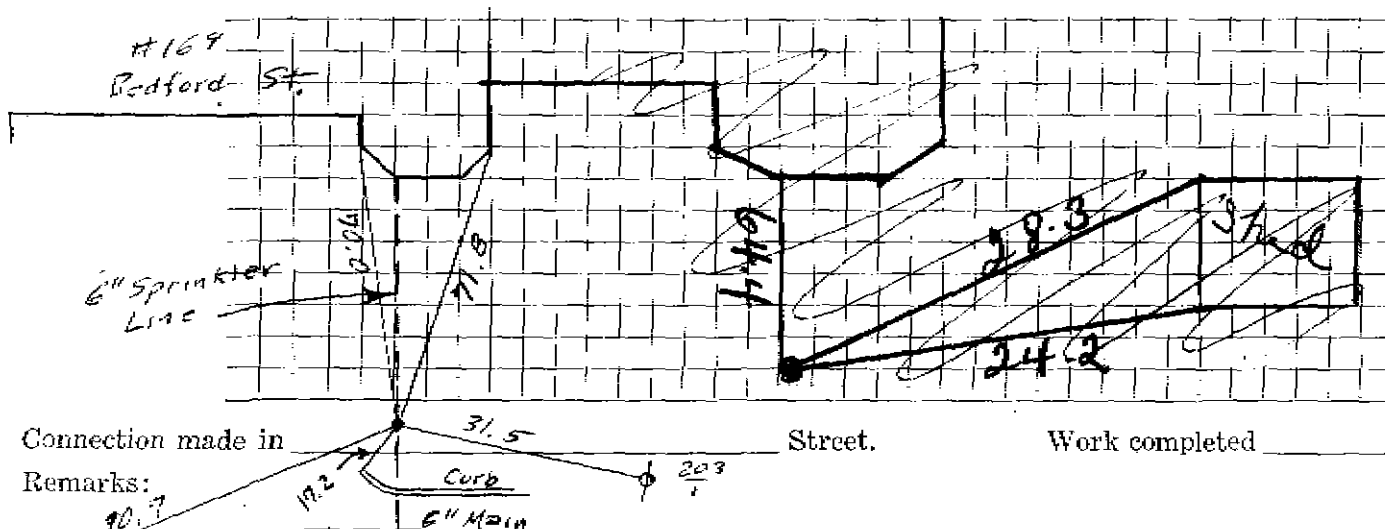

Connection made in _____

Street.

Work completed _____

19 _____

Remarks:

90.7

17.2

6" M.A.

203