

**WATER SERVICE RECORD**

Name Maguire Plumbing & Heating Co.

Service No. 53

Address 171 Bedford St. (LIBERTY Mutual)

Location

Repair—Renewal—New Service W.C. # 7396 Maguire #1196

**JAN 27 1969**


Date	Material	Amount	Total	Date	Amount
9/20/68	Labor	131 13		<del>7-18-68</del>	Deposit 400 00
	Police	38 00		<del>1-27-69</del>	Refund 157 63
	101 C.R.	16 91	186 04		342 37
	6x6 Offset		31 95		
	1/4 Ton Cold Patch		1 38		
	2 Hrs. trucking	3.00	6 00		
	2 " shovel	6.50	13 00		
	1 " loader		4 00		
9-30-68	152' 6" Cast Iron pipe		242 37		
	45' 2" Copper tubing				

DATE \_\_\_\_\_

# TOWN OF LEXINGTON -- BOARD OF PUBLIC WORKS

## WATER DIVISION

Sketch of Service Here

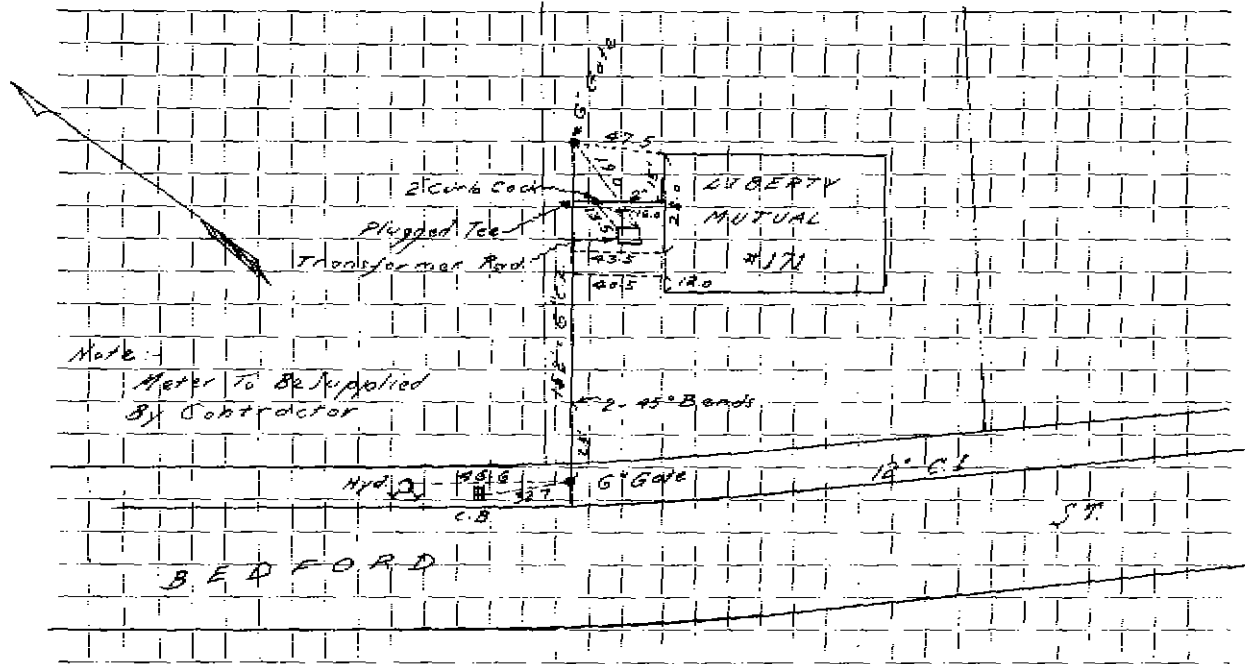

Connection made in ..... Street. Work completed .....

Remarks: .....

.....

.....