

## WATER SERVICE RECORD


Name Outhet Realty TrustService No. 220Address 172-184 Bedford StreetLocation 2-1/2" SERVICE IN ALEXANDER'S NO 180Repair ~~Renewal~~ New ServiceCont 12-12-60

Date	Material	Amount	Total	Date	Amount
10-18-60	Labor	91 08		10-5-60	400 00
	10% O.H.	9 11	99 19	12-12-60	10 41
140	1 1/2 Copper tubing @87		121 80		410 41
2	6x1 1/2 Tapping Saddles @7.04		14 80		
2	1 1/2 Corp Cocks @13.78		27 56		
2	1 1/2 Curb Cocks @28.92		57 84		
2	Buffalo Curb Boxes @12.10		24 20		
2	1 1/2 Comp Valves @11.30		22 60		
2	1 1/2 2 part C to I. Male Couplings		10 18		
2	1 1/2 x 4 Brass Nipple @86		1 72		
2	1 1/2 Brass Elbows @1.30		2 60		
2	Hrs. Town Shovel @6.50		13 00		
2	Hrs. Trucking @3.00		6 00		
	8 x 3 Patch		8 00		
			410 41		

# TOWN OF LEXINGTON — BOARD OF PUBLIC WORKS

## WATER DIVISION

Sketch of Service Here

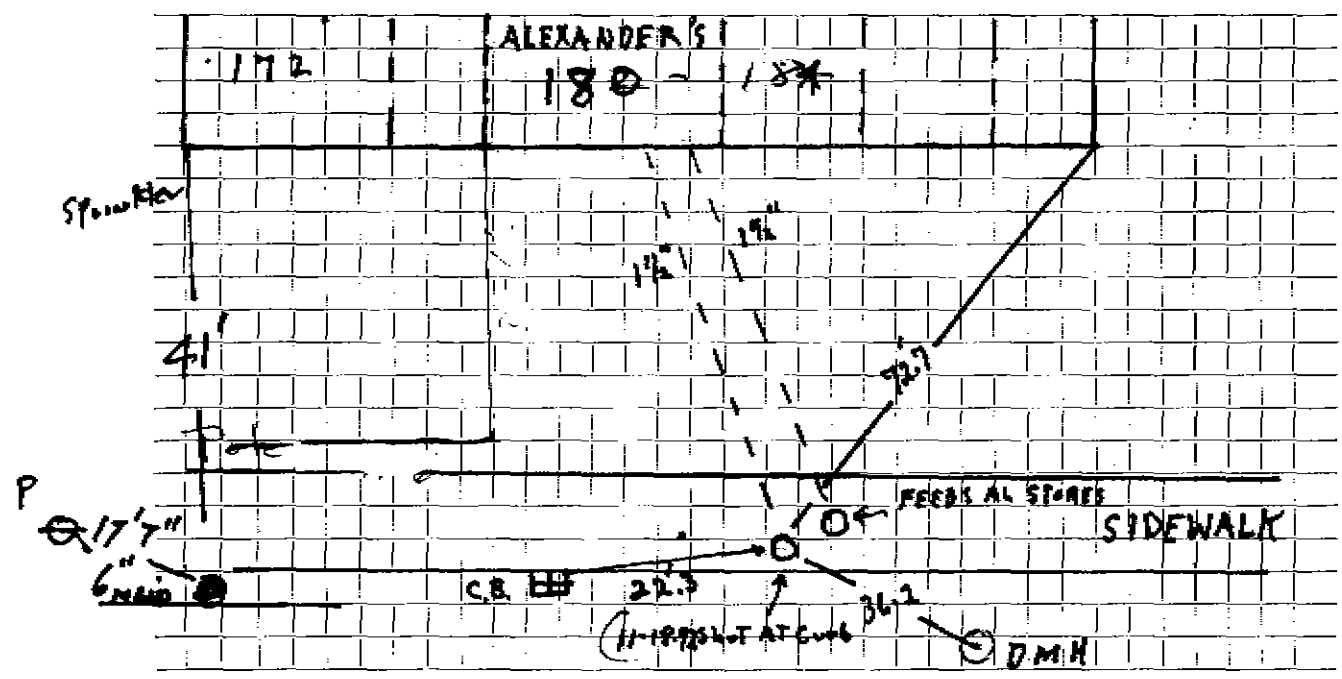

Connection made in ..... Street. Work completed .....

Remarks: 11-18-92 Shut At Curb used To Free Lawnmower - 2 Gate Boxes Side by Side

**WATER SERVICE RECORD**

Name **Bedford Street Realty**

Service No. **179**

Address **172-184 Bedford Street**

Location **SPRINKLER SYSTEM**

~~Repair/Removal~~ **New Service**

*Cum 1278-61*

Date	Material	Amount	Total	Date	Amount
11/27/61	Labor	109 20		11-8-61	600 00
11/28/61	"	100 68		2-7-62	82 22
		209 88			682 22
	10% O.H.	20 99	230 87		
	47' 6" CI Water Pipe @ 2.08		97 76		
	1 6 X 6 Tapping Sleeve & Gate		122 81		
	1 Gate Box		15 95		
	1 6" CI 1/4° Bend		19 18		
	Patching		119 65		
	8 Hrs. Town Shovel @ 6.50		52 00		
	3 Hrs. Compressor @ 3.00		9 00		
	4 Hrs. Trucking @ 3.00		12 00		
	1 Hr. Loader @ 3.00		3 00		
			682 22		


*Paid 12/17/62*

DATE \_\_\_\_\_

# TOWN OF LEXINGTON — BOARD OF PUBLIC WORKS

## WATER DIVISION

Sketch of Service Here

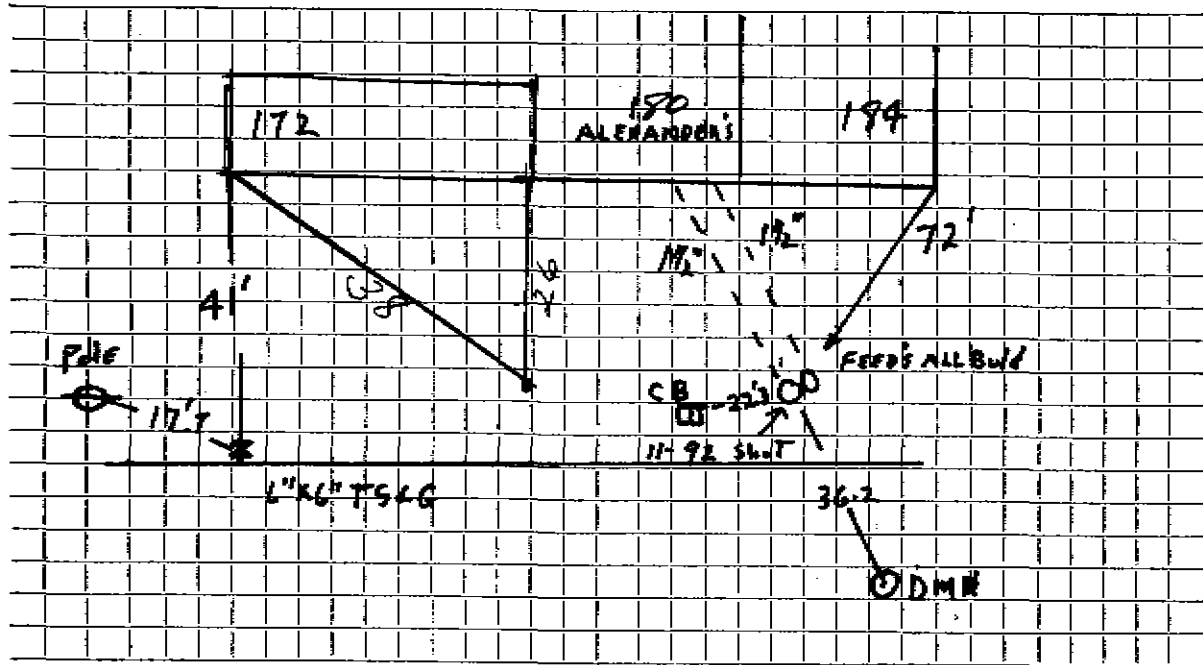

Connection made in ..... Street. Work completed .....

Remarks: .....  
.....  
.....