

WATER SERVICE RECORD

Name Mark Moore - Office Building

Service No.

Address 175 Bedford Street

Location


~~Repair~~ ~~Renewal~~ ~~Reconnect~~ ~~Box~~ New Service Melone

Date	Material	Amount	Total	Date	Amount
6/16/81	28' 1 1/4" Copper tubing				
	4" x 1 1/4" Service Saddle				
	1 1/4" Corporation Comp.				
	1 1/4" Curb Stop				
	Box & Rod				
	<u>SPRINKLER</u>				
6/16/81	48' 4" D.I. P.				
	4" Gate				
	4" x 4" Tap Sleeve & Gate				
	2 Roadway Boxes				

TOWN OF LEXINGTON — BOARD OF PUBLIC WORKS

WATER DIVISION

Sketch of Service Here

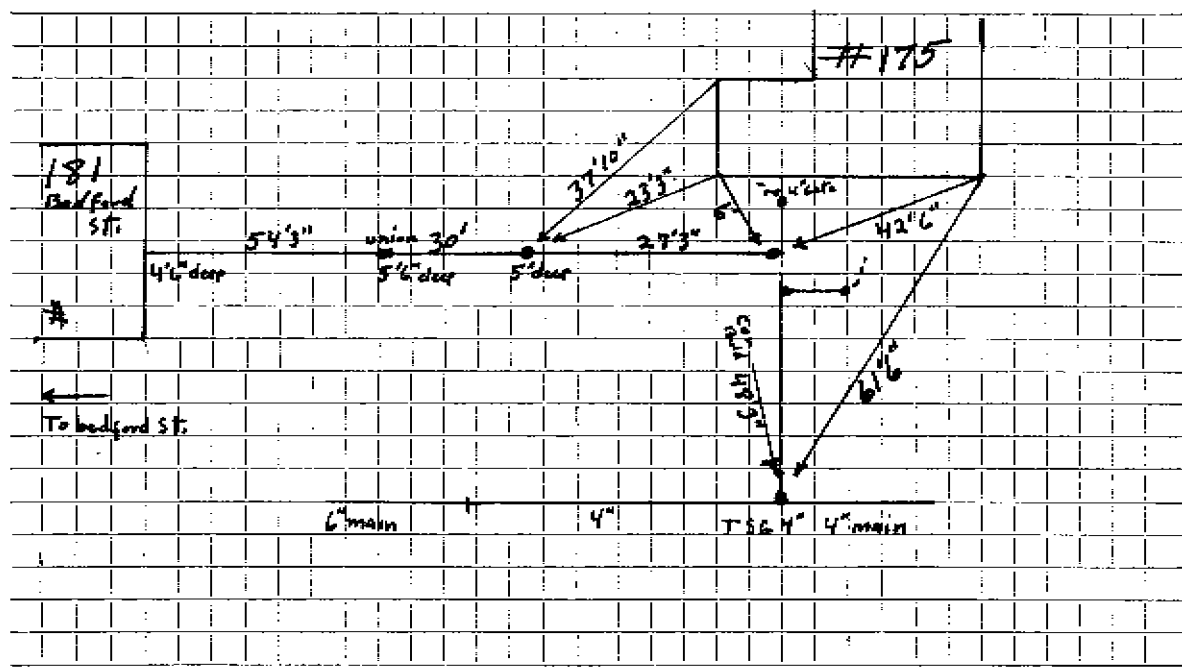

Connection made in Street. Work completed

Remarks:

.....


.....

DATE _____

TOWN OF LEXINGTON — BOARD OF PUBLIC WORKS

WATER DIVISION

Sketch of Service Here

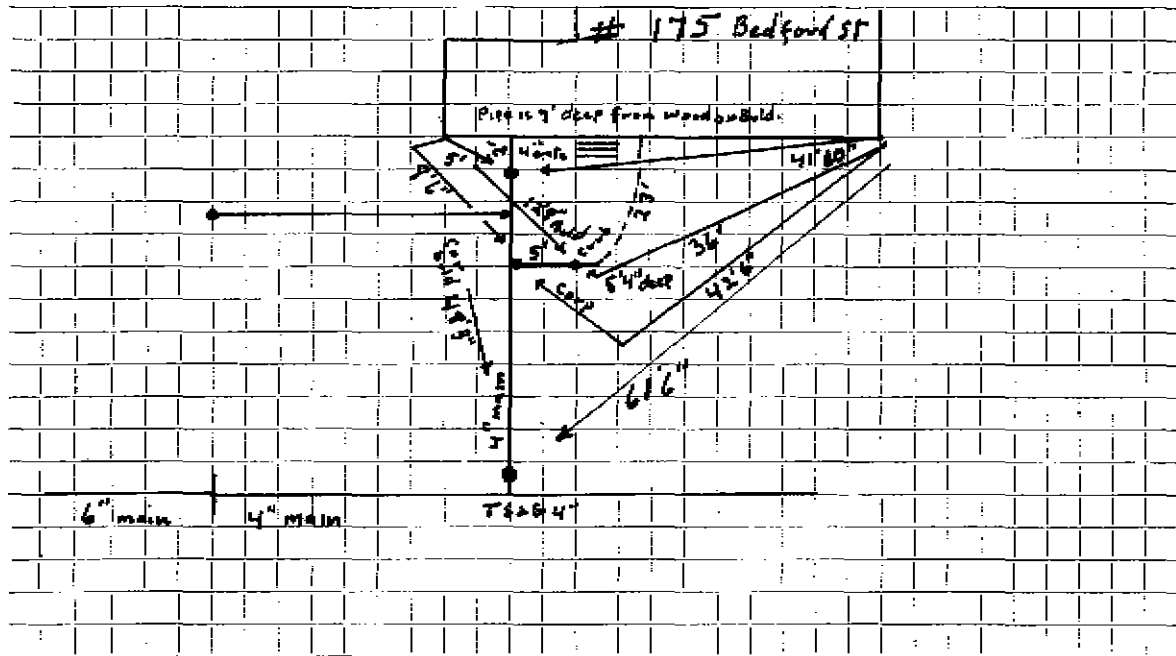

Connection made in Street. Work completed

Remarks:
.....
.....