


DATE _____

TOWN OF LEXINGTON — BOARD OF PUBLIC WORKS

WATER DIVISION

Liberty Mutual
Sketch of Service Here

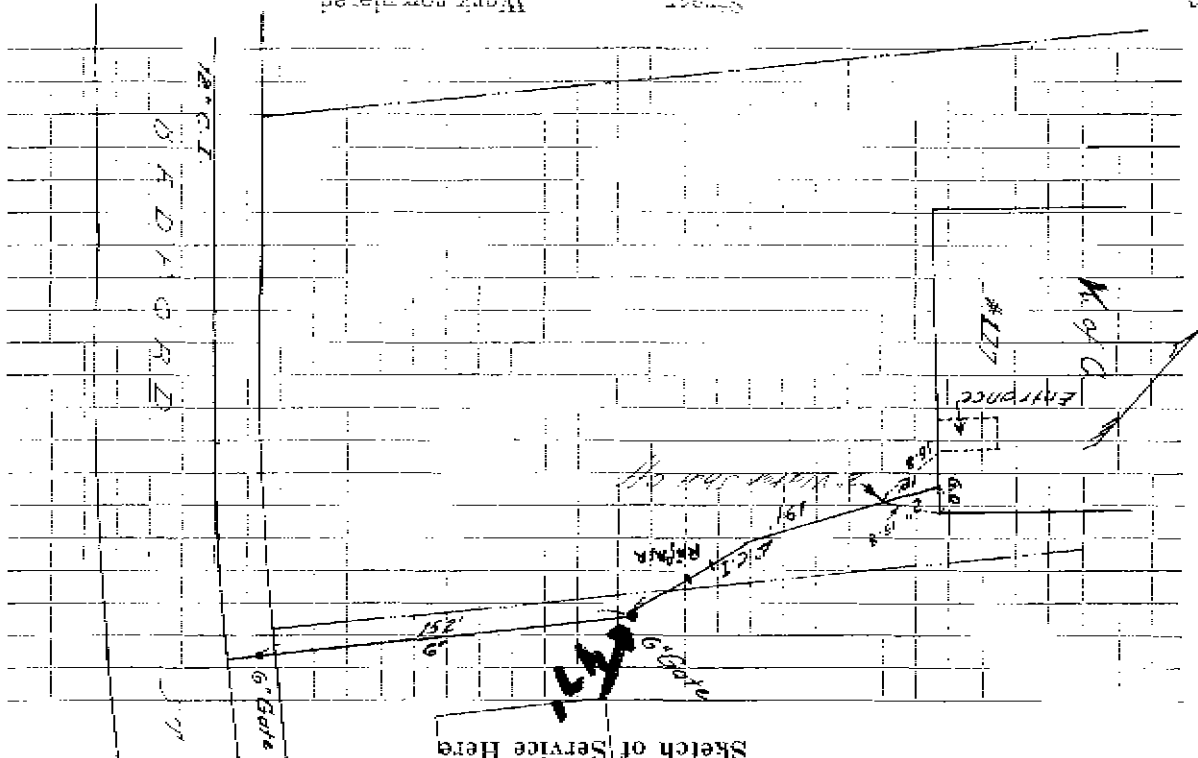

Street _____
Work completed _____

Connection made in _____

Remarks: _____