

Name

Service No. 109

Address 18 + 20 Bedford St.

Locatic 18 + 20 Bedford St.

Kind of Pipe

Size

Size of Main

Repair—Renewal—New Service

Location

Date	Material	Amount	Total	Date	Location	Amount
	Labor				OUTSIDE 3/4" Copper	

DATE \_\_\_\_\_

# TOWN OF LEXINGTON—BOARD OF PUBLIC WORKS

## WATER DIVISION

The undersigned applies for a supply of water at No. \_\_\_\_\_ St. and hereby agrees to comply with the rules and regulations as now, or at any future time, established by the Board of Selectmen.

Am't. of Estimate \$ \_\_\_\_\_

Owner


Am't. Paid \$ \_\_\_\_\_

Address

J. Swan.  
18/20 Bedford St.

Builder \_\_\_\_\_

Sketch of Service Here

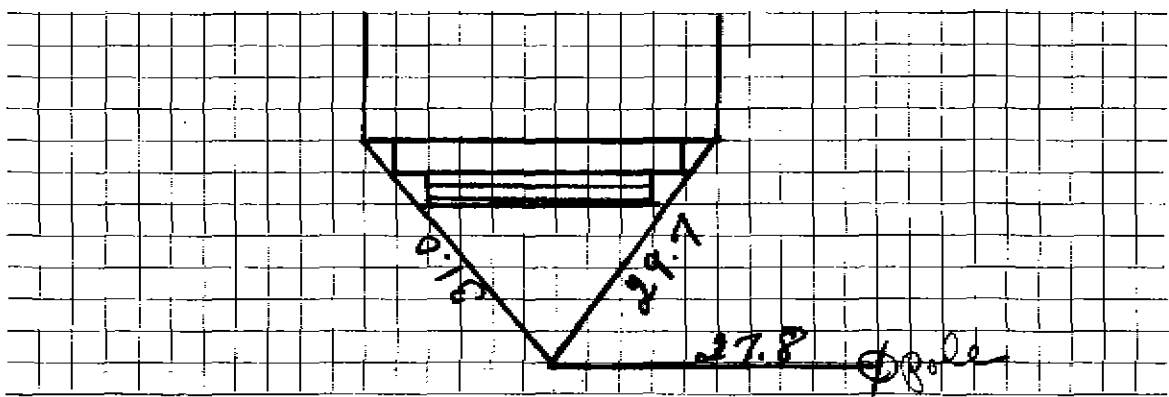

Connection made in \_\_\_\_\_ Street.

Work completed \_\_\_\_\_ 19

Remarks:

WATER SERVICE RECORD

Name

Service No.

Address 18120 Bedford St.

Location


Repair Renewal New Service Kind of Pipe: 1" copper/ type K, Size: 1", Size of Main: 12"

Date	Material	Amount	Total	Date	Amount
	3/4" copper			10-24-00	
				1" corporation off 12" main	
				1 1" x 3/4" union @ 6" ABAN main	
				20' 1" copper BTW corp & union	

DATE 10-24-2000

# TOWN OF LEXINGTON — BOARD OF PUBLIC WORKS WATER DIVISION

Sketch of Service Here

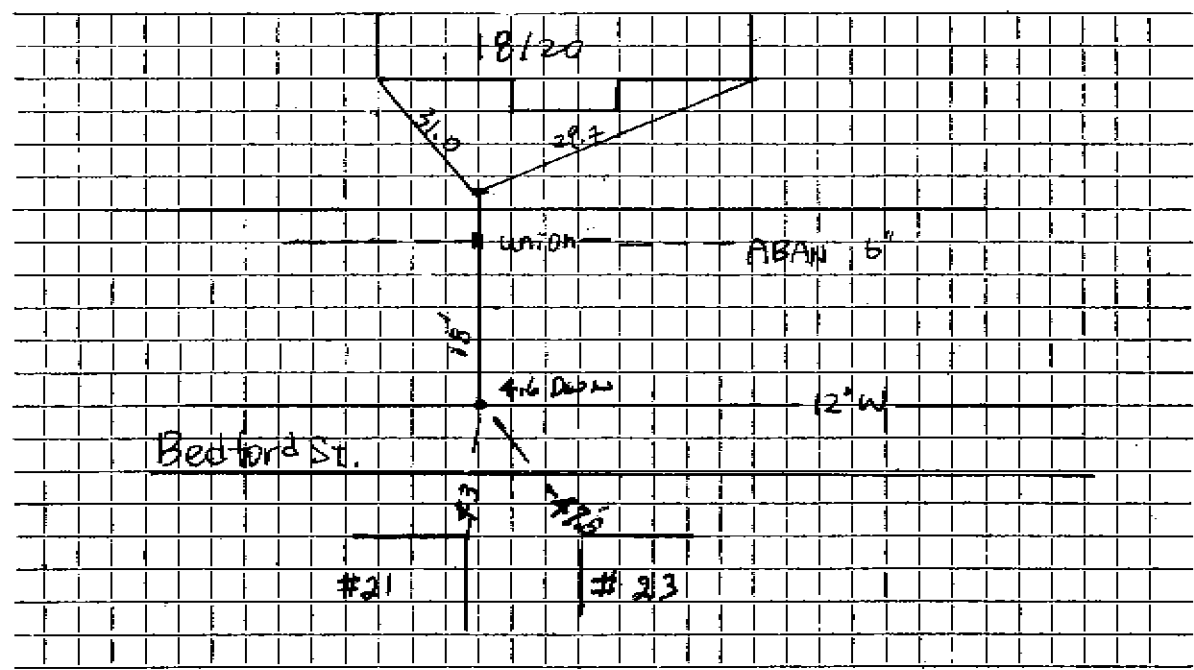

Connection made in Bedford St. / opposite side Street.

Work completed Granese & Sons, Inc (Sub: defelice)

Remarks: Connection to 12" main w/ 1" corp.

Contract 00-12 field-book #1. D.F. 2000.