

WATER SERVICE RECORD

Name Robert O. Tillinghast

Service No. 41

Address 183 Bedford Street

Location

~~Repair~~ Renewal ~~New Service~~ W.O. #2767

SEP 19 1966

Date	Material	Amount	Total	Date	Amount
7-12-66	Labor	59 94		7-1-66	150 00
	10% O.H.	5 99	65 93	7-19-66	32 87
33'	1" Copper tubing @ .99		32 67		117 13
1	1" Nipple		98		
1	3/4" x 1 Union		4 55		
2	Hrs. Tractor @ 6.50		13 00		
			117 13		


Deposit
Refund

DATE _____

TOWN OF LEXINGTON — BOARD OF PUBLIC WORKS

WATER DIVISION

Sketch of Service Here

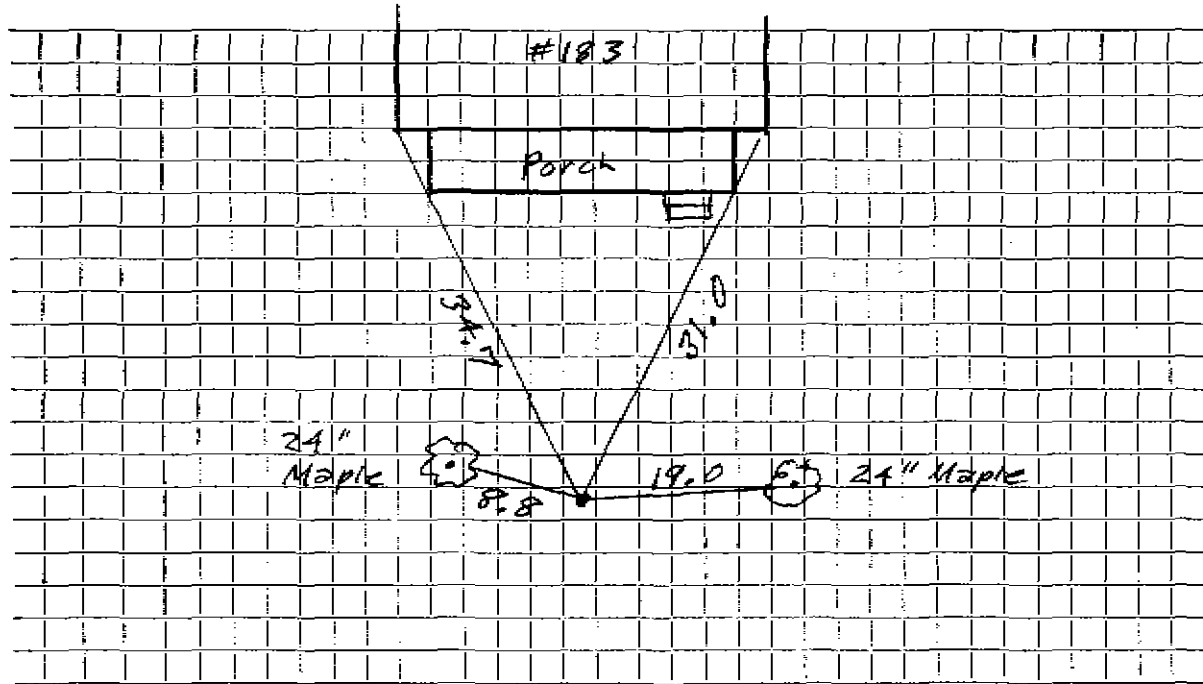

Connection made in Street. Work completed

Remarks:
.....
.....