

WATER SERVICE RECORD

Name William Dini

Service No. 224

Address 186 Bedford Street

Location

~~Repair~~—~~Renewal~~—~~New Service~~

Cmn. 9-6-55


Date	Material	Amount	Total	Date	Amount
8/2/55	Labor	31 81		7-14-55 Deposited	200 00
	10% overhead	3 18	34 99	9-6-55 Refunded	72 08
	110'-1" copper tubing @.4584	50 42			<u>NON CHARGE</u>
	1-1"-3 part union	2 26	52 66	8/1/55 Labor	47 13
	4-2/3 hrs. Littlefield Shovel @7.50	35 00	87 66	8/2/55 Labor	1 85
	1 hr. trucking @.75	75	89 41	8'-1" copper tubing @.4584	3 67
	1-1" C x 1" I.W.E. stop & waste	4 50	93 91	1-1/2" offset tail piece	50
			127 92	1-1/2" straight tail piece	50
				1 corp-cock	5 61
				1 hr. trucking @.75	75
				2-2/3hrs/Littlefield shovel@7.50	20 00
				4 hrs. Ford Comp #37 @ 1.75	7 00
					<u>87 01</u>

DATE _____

TOWN OF LEXINGTON — BOARD OF PUBLIC WORKS

WATER DIVISION

Sketch of Service Here

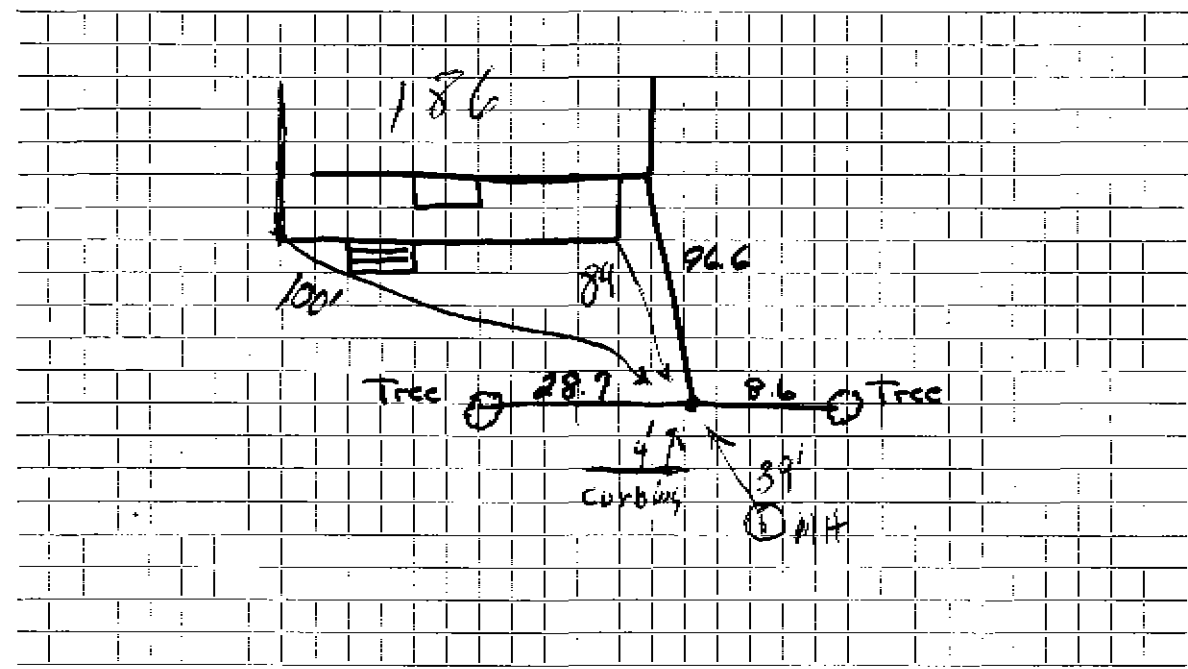

Connection made in Street. Work completed

Remarks:
.....
.....