

Name . George Andrews
 Address 189 Bedford Street
 Lexington, Mass.

Service No. #102

Location 189 Bedford Street

Kind of Pipe

Size

Size of Main

~~Repair~~—Renewal—~~New~~ Service

Location Comm 11-17-58

Date	Material	Amount	Total
6/4/58	Labor	33 14	
	10% Overhead	3 31	36.45
	40' 3/4" Copper Tubing		14.80
	1 3/4" Cx 1/2 I.W.H Stop & Waste	5 84	
	1 Hour Town Shovel @ 6.50	6.50	
	1 Hour Trucking @ 75		.75
			<u>64.34</u>
	Labor		

Date	Amount
6-3-58	75 00
11-17-58	10 66
	<u>64 34</u>
	Non-Charge
Sent. 13, '47 Labor	44 33
30' - 3/4" Copper Tubing @ .26	7 80
1 - 3/4" C Corp-cock	3 00
1 - 3/4" C x 3/4" C Curb-cock	3 68
1 - 3/4" C x 3/4" C Union (3pts)	1 17
1 - 1" I x 3/4" C Union (2 pts.)	1 17
1 - Box & Rod	4 26
Patching 13 x 3	13 00
Trucking 1 hr. @ .75	75
	<u>79 16</u>
1 1/2 Straight Tail Piece	50
1 1/2 OffSet Tail Piece	50
	<u>80 16</u>

DATE _____

TOWN OF LEXINGTON - BOARD OF PUBLIC WORKS

WATER DIVISION

The undersigned applies for a supply of water at No..... St. and hereby agrees to comply with the rules and regulations as now, or at any future time, established by the Board of Selectmen.

Am't of Estimate \$.....

Owner


Am't Paid \$.....

Address

Builder

.....

Sketch of Service Here

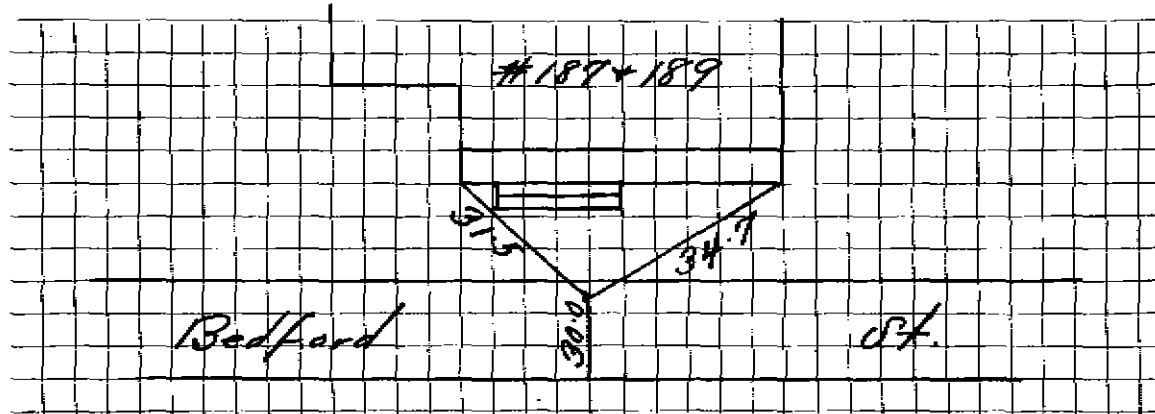

Connection made in Street.

Work completed19

Remarks: