

WATER SERVICE RECORD


Name _____ Service No. _____
 Address 19 Bedford Street # 7749
 Location _____
 Repair—~~Removal~~ ~~New Service~~

Date	Material	Amount	Total	Date	Amount
12/6/27	36' CLP				
	REPAIR				
11/13/94	3' 3/4" COPPER				
	1" Coupling				Non-charge
	1 X 4 BRASS NIPPLE			4-4-62	Labor 74.54
	1" FX 3/4" COPPER			4-5-62	Labor 74.54
					10' 3/4" Copper tubing @ .42 4.20
					1 3/4" C Corp Cock 4.91
					1 3/4" C Curb Cock 6.28
					1 1" Lead Lined Coupling .60
					165.07

TOWN OF LEXINGTON — BOARD OF PUBLIC WORKS

WATER DIVISION

Sketch of Service Here

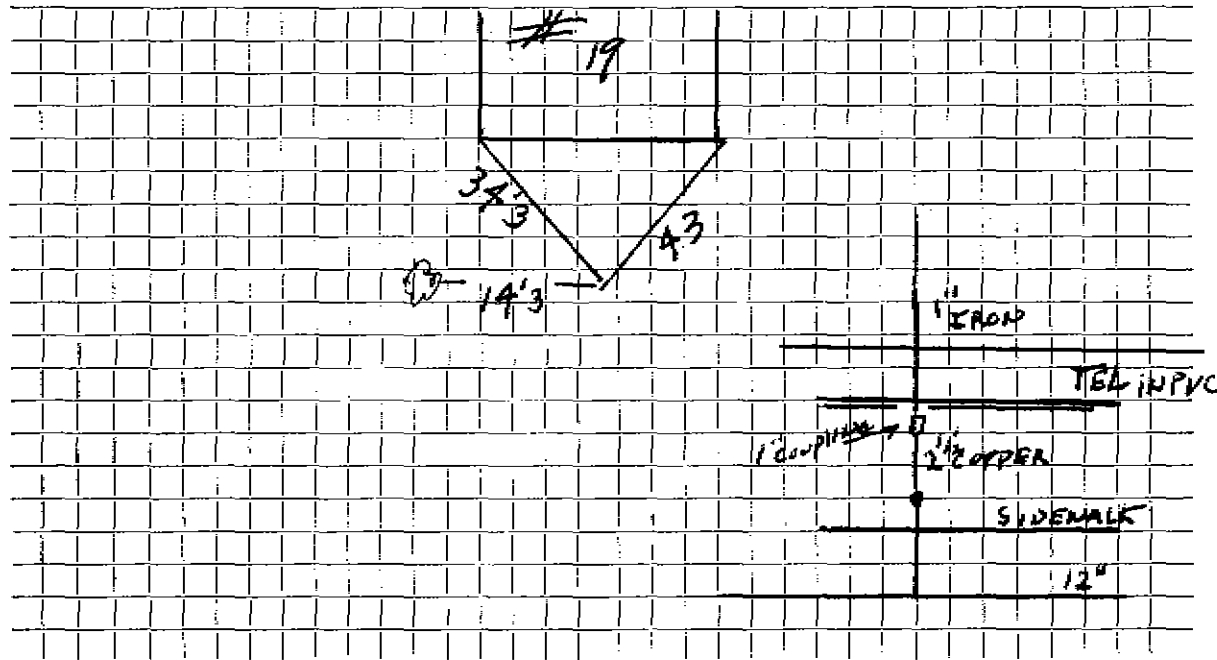

Connection made in Street..... Work completed :

Remarks:

.....

.....