


DATE 11/1/19

TOWN OF LEXINGTON — BOARD OF PUBLIC WORKS
WATER DIVISION

Sketch of Service Here

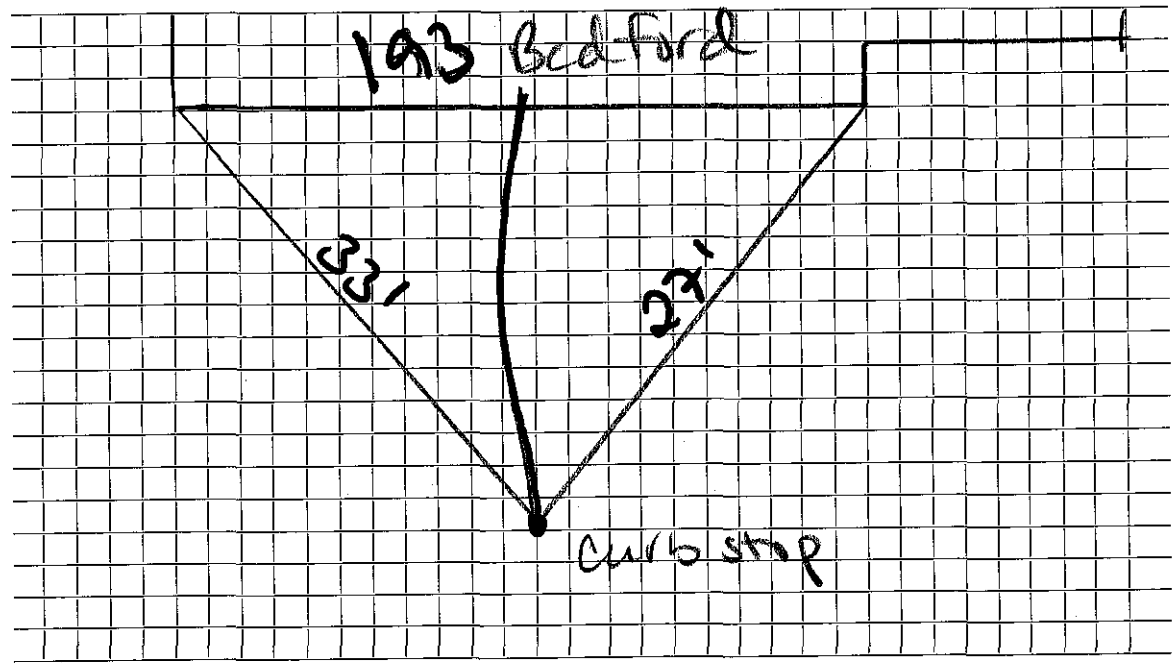

Connection made in Bedford Street. Work completed

Remarks:
.....
.....