

WATER SERVICE RECORD

Name Wallace G. Weisinger

Service No. 156

Address 193 Bedford Street

Location

Repair ~~Repair~~ - New Service

Comm 9-24-56


Date	Material	Amount	Total	Date	Amount
6/16/56	Labor	1 95		6-12-56	Deposit 25 00
	10% overhead	20	2 15	9-24-56	Refund 7 89
	1 3/4 Cx 1/2 I.W.H. Stop & Waste		4 96		NON CHARGE 17 11
	10x3 patching		10 00	6/16/56	Labor 31 03
			17 11	12' - 3/4" Copper tubing @ .4850	5 82
				1 Corp. Cock	4 34
				1 Box & Rod	4 62
				1 hr. trucking	75
				1 1/2" straight tailpiece	50
				1-1/2" Offset tailpiece	50
				2 hrs. Littlefield Shovel @ 8.50	17 00
					64 56

DATE \_\_\_\_\_

TOWN OF LEXINGTON — BOARD OF PUBLIC WORKS

WATER DIVISION

Sketch of Service Here

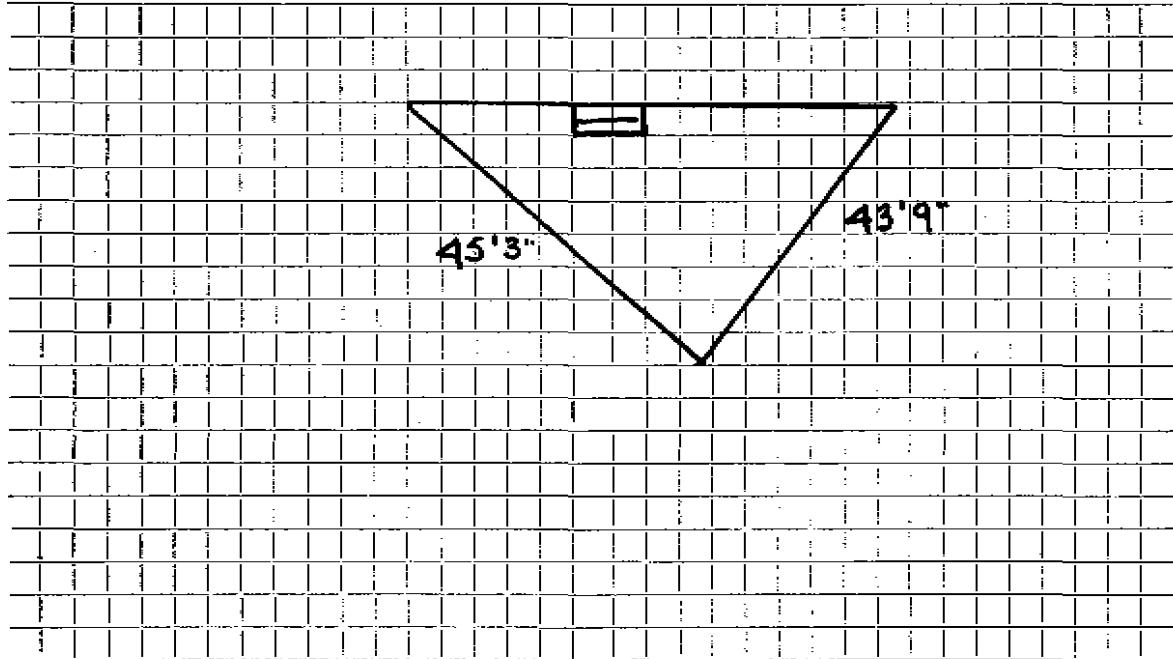

Connection made in ..... Street. Work completed .....

Remarks: .....  
.....  
.....