


DATE _____

TOWN OF LEXINGTON — BOARD OF PUBLIC WORKS
WATER DIVISION

Sketch of Service Here

Tie 62-1

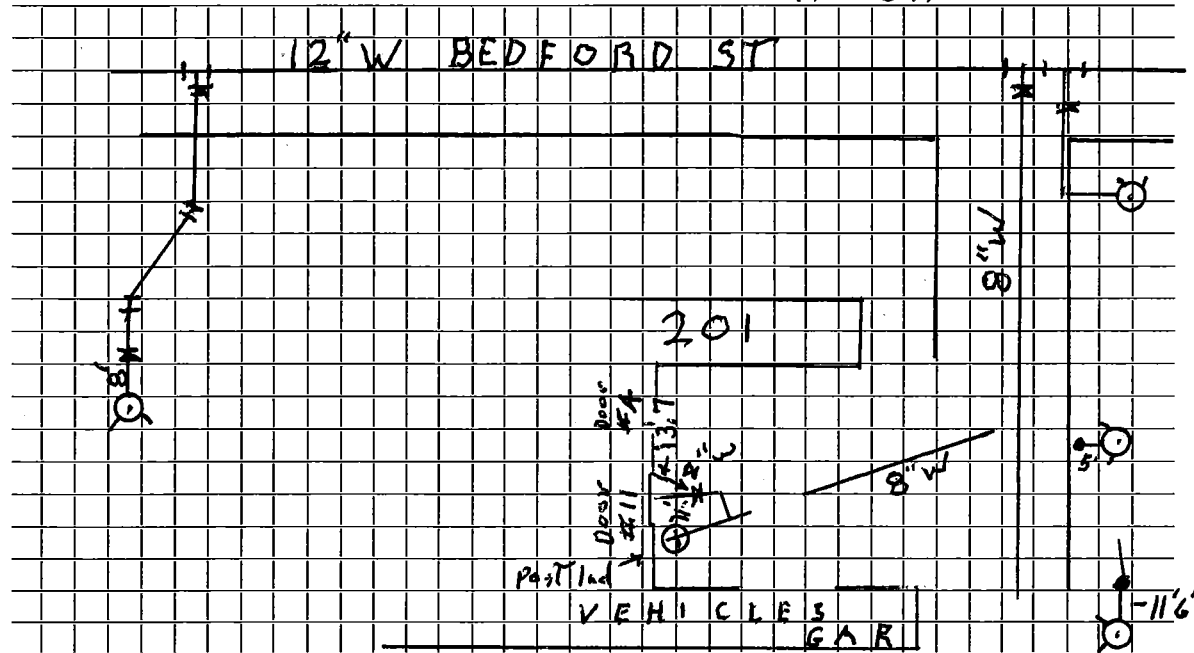

Connection made in Street. Work completed

Remarks: Used old 12x6 TSC for Hyd.

.....
.....