

WATER SERVICE RECORD

Name Estate of Arthur Gorman

Service No. 76

Address 206 Bedford Street

Location

~~Repair~~—Renewal—~~New Service~~ W. O. # 248

FEB 12 1973


Date	Material	Amount	Total	Date	Amount
11/10/72	Labor	134 40		11/2/72	Deposit 200 00
	10% O.H.	13 44	147 84	2/15/73	Balance 124 53
134'	3/4" Copper pipe	.79	105.86	4/19/72	OUTSIDE 324.53
2	3/4" 3 Part Union	6.91	13 82	9'	3/4 COPPER
1	3/4" C X 1/2" Wheel Handle		12 01	1	3/4 CORP
2	Hrs. Trucking	3.00	6 00	1	3/4 CURB
6	Hrs. Shovel	6.50	39 00		Box & Rod
			324.53		

DATE _____

TOWN OF LEXINGTON — BOARD OF PUBLIC WORKS

WATER DIVISION

Sketch of Service Here

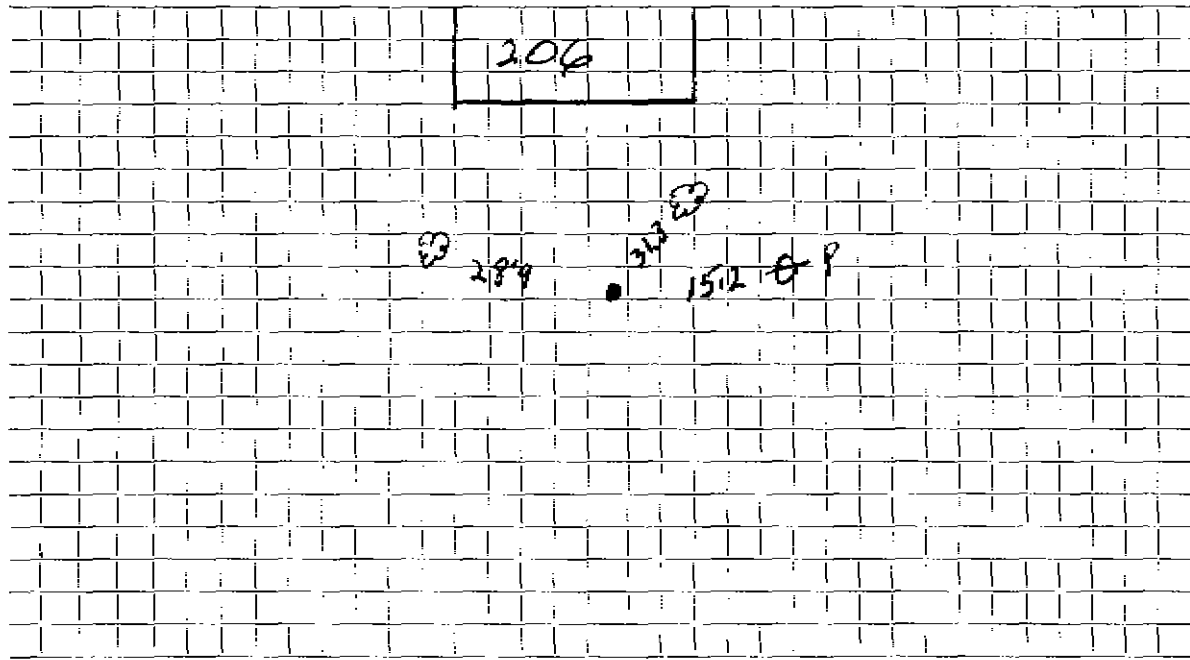

Connection made in Street. Work completed

Remarks:

.....

.....