

WATER SERVICE RECORD

Name

Service No.

Address 21 Bedford Street

419

Location outside

~~REPAIR~~ - Renewal - ~~WORK SERVICE~~

W.O. # 8395


Date	Material	Amount	Total	Date	OUTSIDE	Amount
12/2/27	36' ELP			1/3/72	Labor	91.80
				4/4/72	"	50.99
525.00	35' 1" - Copper				8' 3/4" copper pipe @.79	6.32
	1 - 3/4" x 1" 3 pt union				1 3/4" corporation	9.57
					1 3/4" curb cock	11.32
					1 1" repair clamp	5.05
					1 1" coupling	3.00
					1 1" x 1/2" nipple	.60
					1 1/2 Ton hot top @ 7.45	11.18
					1/4 Ton cold patch @ 8.00	2.00
					2 1/2 Hrs. shovel @ 4.00	10.00
					1/2 Hr. compressor @ 3.00	1.50
					1/2 Hr. roller @ 2.00	1.00
					TOTAL:	\$ 201.33

DATE _____

TOWN OF LEXINGTON — BOARD OF PUBLIC WORKS

WATER DIVISION

Sketch of Service Here

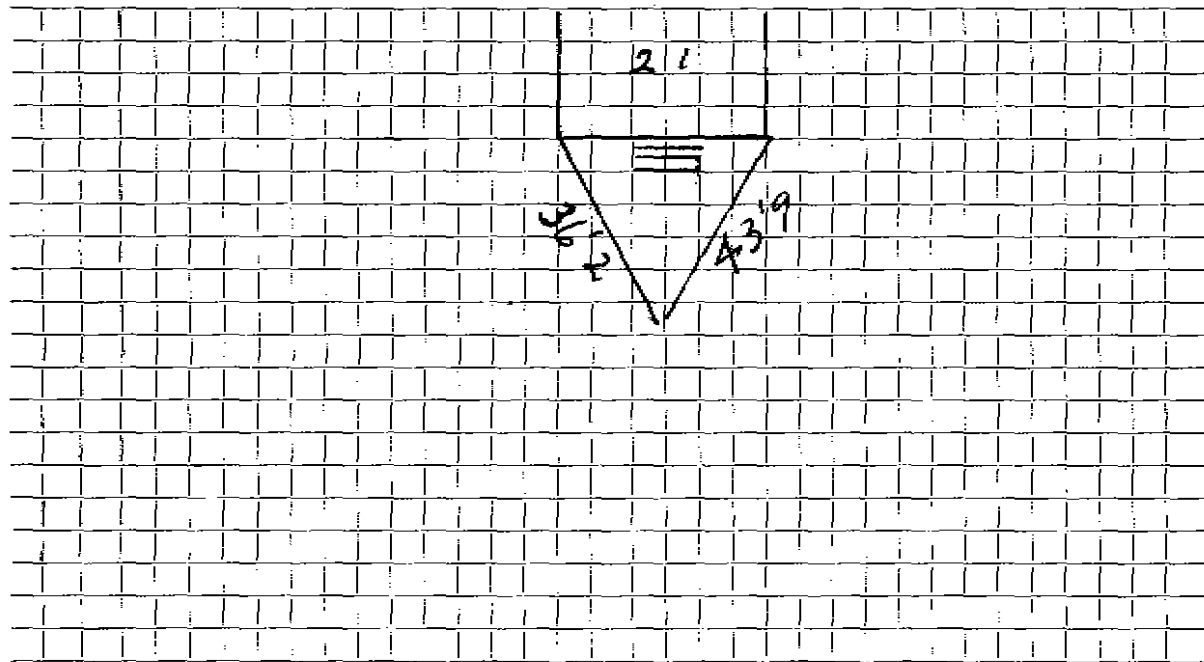

Connection made in Street. Work completed

Remarks:
Contractor installed 1" Copper inside - NO INSPECTION
WAS DONE