

WATER SERVICE RECORD

Name

GEORGE ARNOLD

Service No.

Address

525 S. ...

Location

Repair—Renewal—New Service


RENEWAL - BRUCE MCKEE - #845

| Date | Material | Amount | Total | Date | Material | Amount |
|---------|---|--------|-------|---------|-----------------------|--------|
| 7/16 96 | 47.6' OF 1" COPPER 1- 1"x1" COUPLING | | | | | |
| | | | | | OUTSIDE | |
| | | | | 8/13/73 | 9' 3/4" Copper tubing | |
| | | | | | 1 3/4" Corp | |
| | | | | | 1 3/4" Corp Cock | |

DATE 7/18/96

TOWN OF LEXINGTON — BOARD OF PUBLIC WORKS
WATER DIVISION

Sketch of Service Here

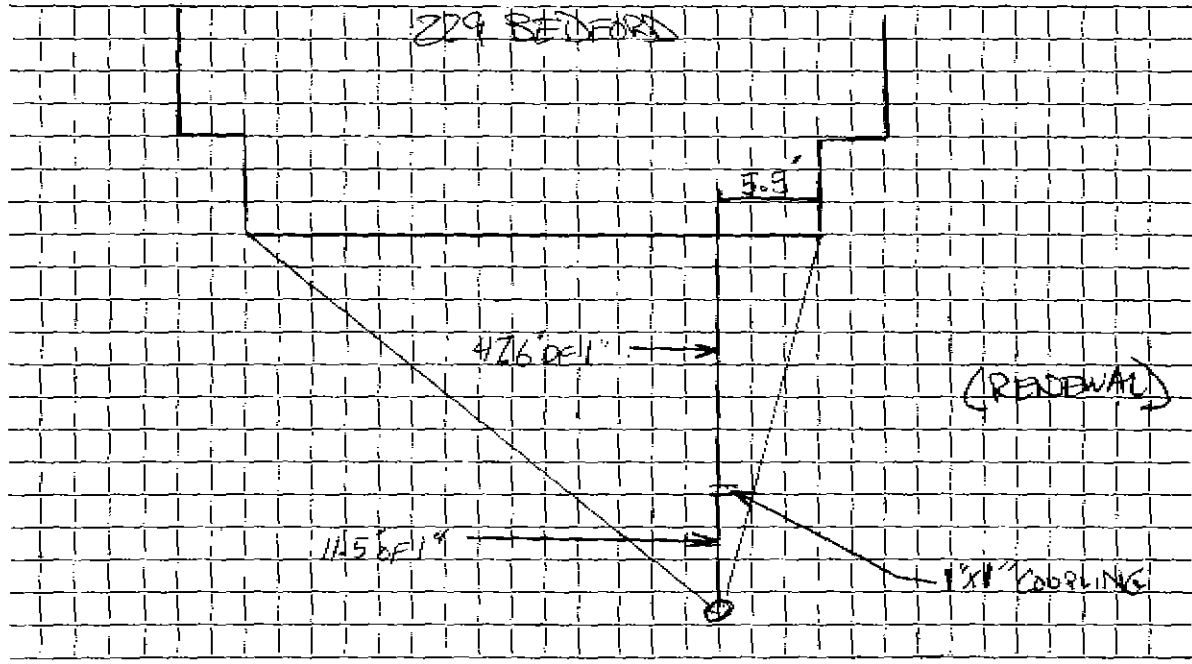

Connection made in Street. Work completed

Remarks:
.....
.....