

Name

Service No. 113

Address 23 Bedford Street

5866

Locatic 23 Bedford St.

Kind of Pipe

Size

Size of Main

~~Repair~~—Renewal—~~WORK ORDER~~ ^{W.O. #} 6737

Location

Date

MAIN TO CURB

Material

Amount

Total

Date

Amount

5/21/68

Labor

60 29

10" 6" copper @ .79

7 90

3/4" Coup

9 57

3/4" curb

11 32

3/4" repair clamp

5 05

3/4" 3" C.L. nipple

23

3/4" brass coupling

2 60

1 box & rod

5 10

2 hrs. trucking @3.00

6 00

1 1/2 hrs. compressor @5.00

7 50

1/2 hrs. roller @3.00

1 50

trailer

2 00

Labor

Total

\$119 06

DATE _____

TOWN OF LEXINGTON—BOARD OF PUBLIC WORKS

WATER DIVISION

The undersigned applies for a supply of water at No. _____ St. and hereby agrees to comply with the rules and regulations as now, or at any future time, established by the Board of Selectmen.

Am't. of Estimate \$ _____

Owner


Am't. Paid \$ _____

Address

John Hinchey
23 Bedford St.

Builder _____

Sketch of Service Here

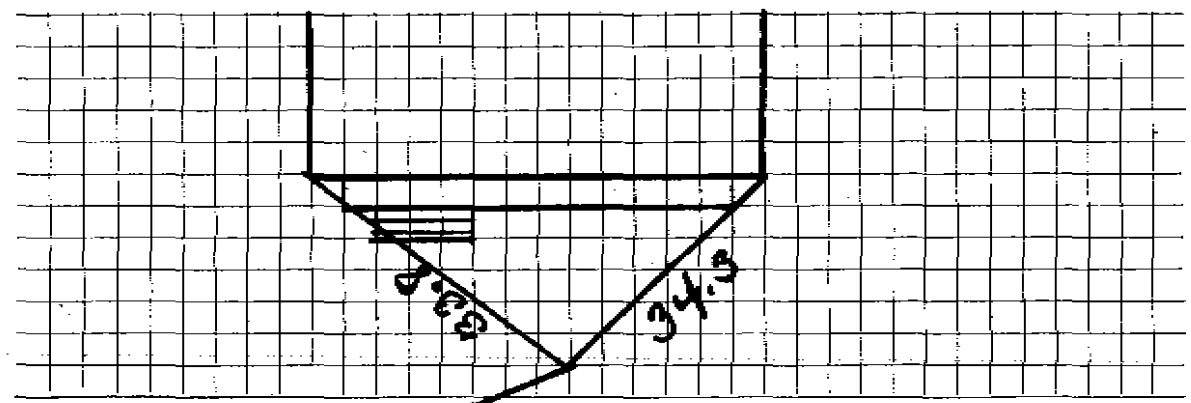

Connection made in _____ Street.

Work completed _____ 19

Remarks:

8.3
47.0