

Name

Service No.

Address 231 Bedford Street

Lexington, Mass.

Location 231 Bedford Street

Kind of Pipe

Size

Size of Main

~~REPAIR~~ - Renewal - ~~NEW SERVICE~~

Location

Date	Material	Amount	Total	Date	Amount
				Jan 21, 1929	Cash 26 75
					Non-Charge
p 12/31/28 for	26.75				
25'	1" C.L. Pipe @ .27	6 75		Nov. 17, 14	Labor 32 07
1	1" L. L. Coup.	30		28' - 3/4"	Copper Tubing @.28 7 28
1	1" L.L. Ell	35		1 - 3/4"	Copper Adapter 1 32
1	1" Br. Cl. Nipple	30		1 - 3/4"	C x 3/4" C Curb-cock 3 68
1	S & W	3 00		1 - 3/4"	C x 3/4" C Union (3pts) 1 17
	Trucking	75	11 45	1 - 3/4"	C x 3/4" I Union (2pts) 1 17
11/28/28	22 Hrs. Labor @ .55		12 10	Compressor 3 hrs. @ 1.75	5 25
	2 Hrs. Labor @ .60		1 20	Trucking labor @ .75	75
	15% Overhead		2 00	Patching 28 x 3	26 00
	Labor		26 75		78 69

TOWN OF LEXINGTON - BOARD OF PUBLIC WORKS

**WATER DIVISION**

The undersigned applies for a supply of water at No..... St. and hereby agrees to comply with the rules and regulations as now, or at any future time, established by the Board of Selectmen.

Am't of Estimate \$.....


Owner .....

Am't Paid \$.....

Address .....

Builder .....

Sketch of Service Here

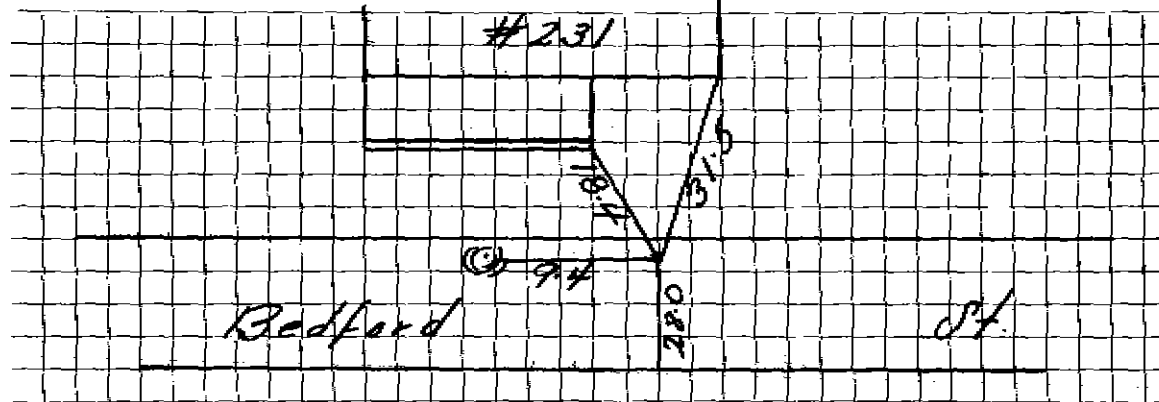

Connection made in ..... Street.

Work completed .....19

Remarks: