

WATER SERVICE RECORD

Name

Service No.

Address 234 Bedford St.


Location B & M Vacant Lot

~~Repair~~ ~~Reconnect~~ New Service

Date	Material	Amount	Total	Date	Amount
				6-27-59	NON CHARGE
				23'	1" Copper tubing @.5202 X3180X 11.96
				1	1" C Curb Cock 7.64
				1	1" C Corp Cock 7.06
				1	Box & Rod 5.00
					Labor 3.70
					<u>35.36</u>

DATE _____
 TOWN OF LEXINGTON — BOARD OF PUBLIC WORKS
 WATER DIVISION

Sketch of Service Here

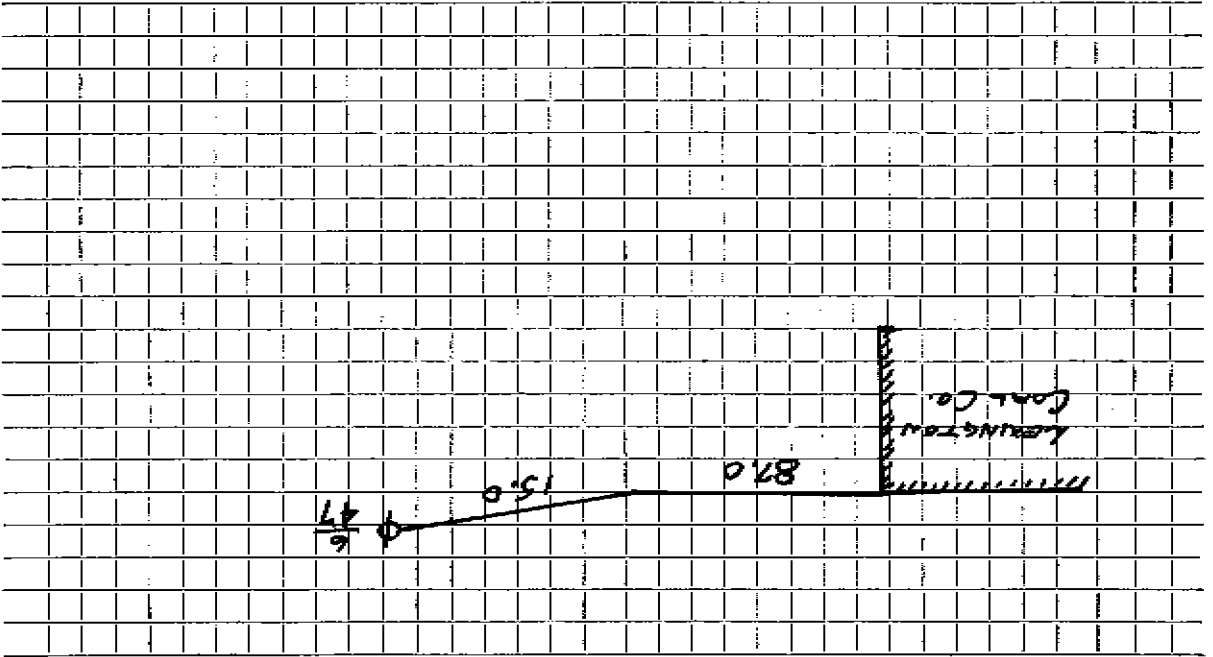

Connection made in _____

Street _____

Work completed _____

Remarks: _____

This service was pulled out of man and not replaced still in sidewalk water
 curb is probably