

WATER SERVICE RECORD

#4293

Name Arthur Mitchell

Service No. 255

Address 235 Bedford Street

Location

Repair or Renewal - New Service

Inst. 11-9-53

Date	Material	Amount	Total	Date	Amount
10/6/53	Labor	1 75		10/6/53	1 75
	10% overhead	18	1 93	11-9-53	5 99
	34'-3/4" copper tubing@.3629		12 38		19 01
	1 -3/4" C x 1/2 I.R.H. stop & waste		4 00	10/6/53 Labor	1 75
	1 hr. trucking		75	17' - 3/4" copper tubing@.3629	6 17
			19 01	1 -3/4" C. corp-cock	4 33
				1 -3/4" C x 3/4" C. curb-cock	4 67
				1 box and rod	3 90
				1 -1/2 straight tail pc.	50
				1 -1/2 offset tail pc.	50
				1 hr. trucking	75
					22 57


Deposited  
Refunded  
NON CHARGE

DATE \_\_\_\_\_

TOWN OF LEXINGTON — BOARD OF PUBLIC WORKS

**WATER DIVISION**

Sketch of Service Here

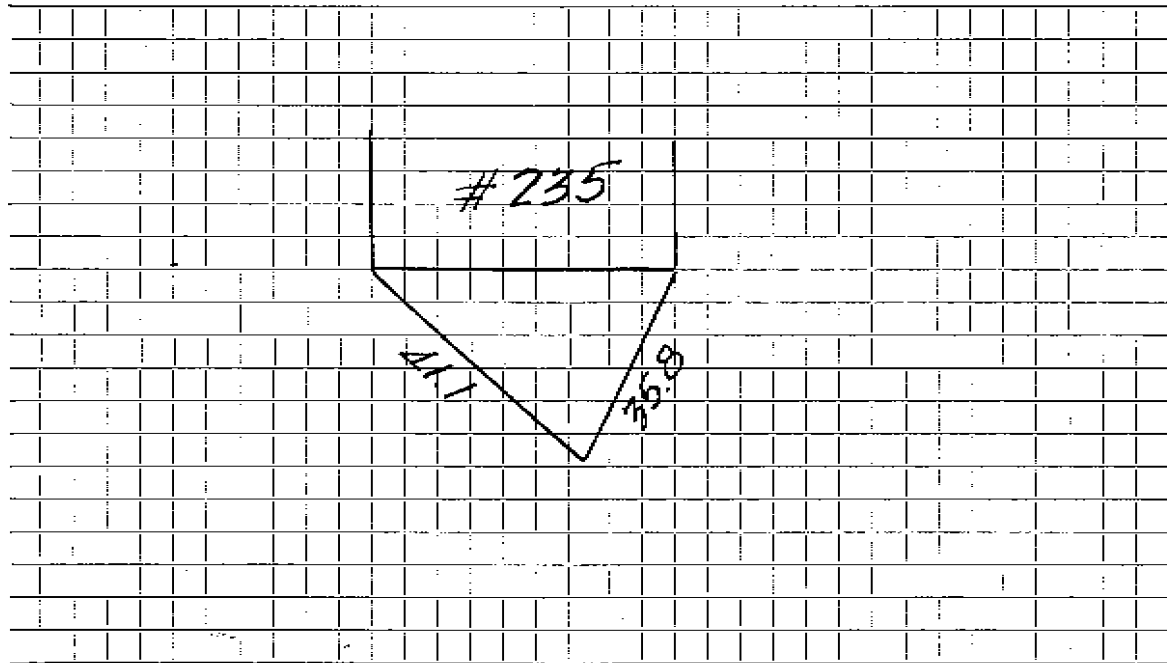

Connection made in ..... Street. Work completed .....

Remarks: .....

.....

.....