




DATE 10-24-2000

# TOWN OF LEXINGTON — BOARD OF PUBLIC WORKS WATER DIVISION

Sketch of Service Here

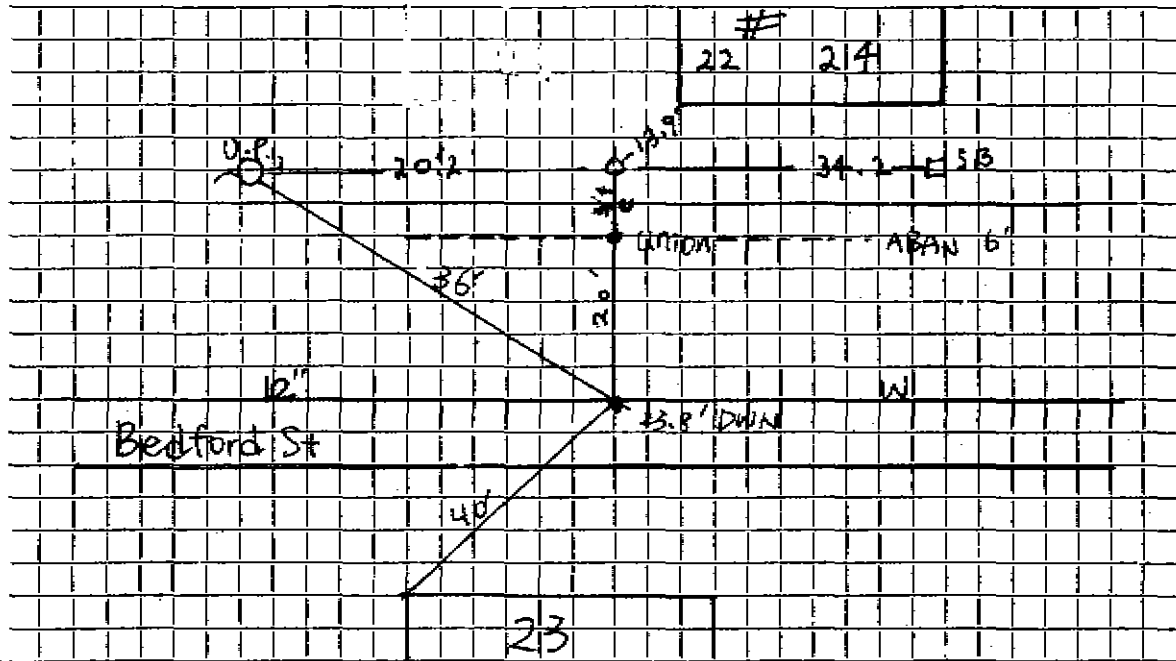

Connection made in Bedford St. / opposite side Street.

Work completed Granese & Sons, Inc (Sub: ~~def (no)~~ )

Remarks: Connection to 12" main w/ 1" copper

Contract 00-12 field book #1 P.F. 2000

**WATER SERVICE RECORD**

Name **Matt K. Swan**

Service No. **21**

Address **24 Bedford Street**

Location

~~Repair~~ - ~~Renewal~~ - ~~New Service~~ **W.O.#6716**

**AUG 5 1968**

Date	Material	Amount	Total	Date	Amount
5/14/68	Labor	41 92		5-15-68	100 00
	10% O.H.	4 19	46 11	8-5-68	20 54
	18' 3/4" copper @.79		14 22		79 46
	3/4" Stop & Waste		11 13		
	1 hr. compressor		5 00		
	1 hr. trucking		3 00		
		<b>TOTAL COST</b>	<b>79 46</b>		

