


DATE August 1983

TOWN OF LEXINGTON — BOARD OF PUBLIC WORKS
WATER DIVISION

Sketch of Service Here

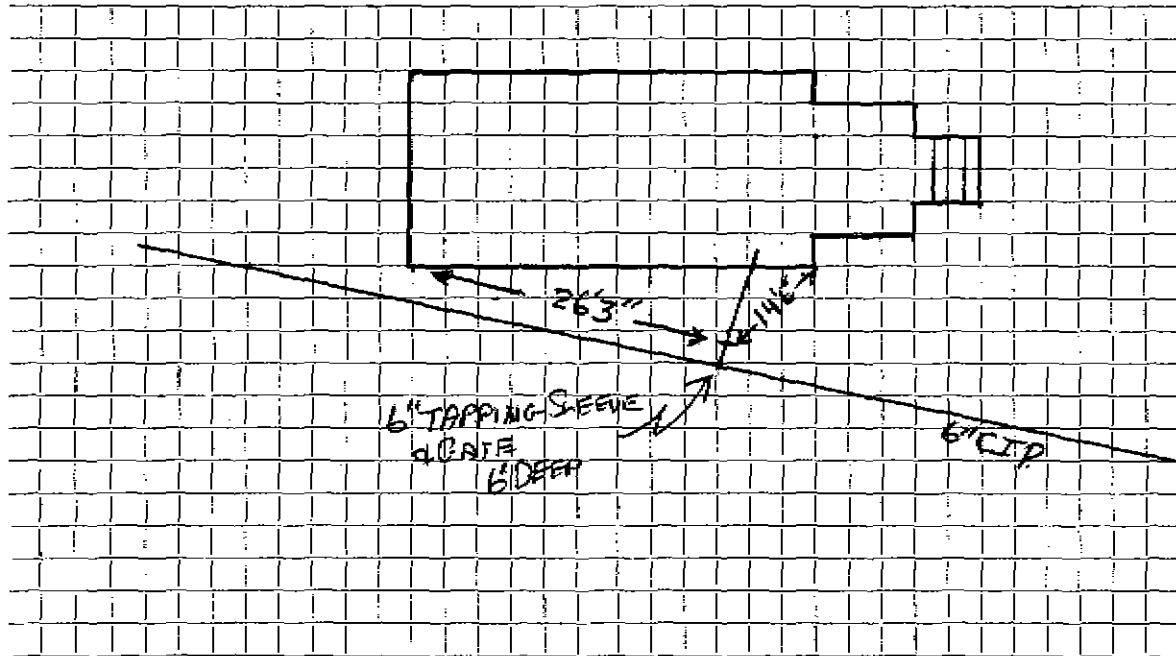

Connection made in Street. Work completed August 12, 1983

Remarks:
.....
.....

