

Name Lexington Coal Company

Service No. 169 R.D. 291

Address 242 Bedford Street

Location 242 Bedford St.

Kind of Pipe

Size

Size of Main

~~Repair~~—Renewal—~~New Service~~

Location

Chase 123.58

Date	Material	Amount	Total	Date	Amount	
9-30-58	Labor	3.82		2-9-59	Paid	18.19
	10% O.H.	.38	4.20			
20'	3/4" Copper tubing @.37		7.40			
1	3/4" C x 1/2 I.S.H. Stop & Waste		5.84			
1	hr. Trucking @.75		.75			
			<u>18.19</u>			
					NON CHARGE	
	Labor				Labor	3.70
				10'	3/4" Copper tubing @.37	3.70
				1	3/4" Corp Adapter	1.95
				1	3/4" C Curb Cock	6.08
				1	Box & Rod	5.00
				1	1/2 Straight tailpiece	.50
				1	1/2 Offset tailpiece	.50
						<u>21.38</u>
	Labor					

Hadley Press, Inc., Lexington

## TOWN OF LEXINGTON — BOARD OF PUBLIC WORKS

### WATER DIVISION

The undersigned applies for a supply of water at No. \_\_\_\_\_ St. and hereby agrees to comply with the rules and regulations as now, or at any future time, established by the Board of Selectmen.

Am't. of Estimate \$ \_\_\_\_\_


Owner Lep Coal Co

Am't. Paid \$ \_\_\_\_\_

Address 242 Bedford St

Builder \_\_\_\_\_

Sketch of Service Here

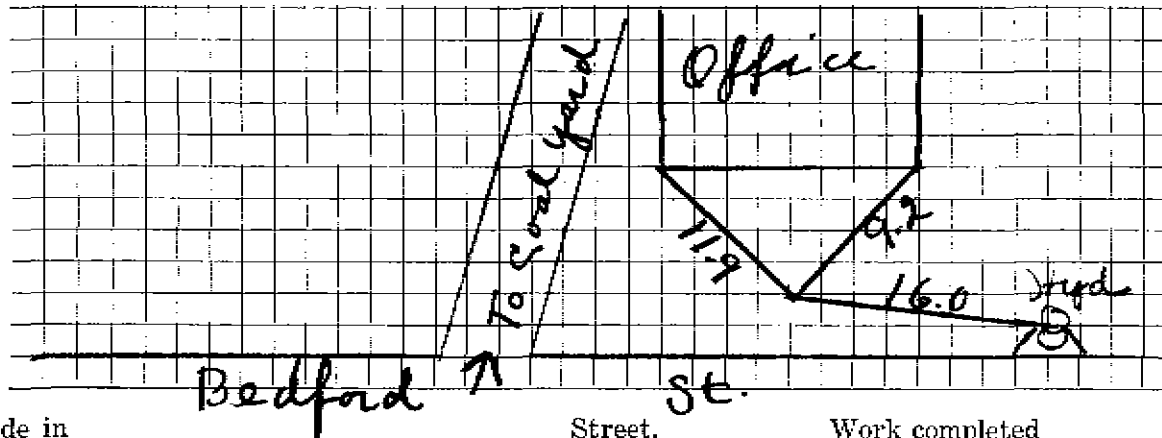

Connection made in Bedford Street. Work completed \_\_\_\_\_ 19\_\_

Remarks: