

WATER SERVICE RECORD

Name LEX COAL CO.

Service No.

Address 242 B BEDFORD ST

Location OLD GARBAGES

Repair—Renewal—New Service

Date	Material	Amount	Total	Date	Amount
1964	1 1/2" COPPER TEE HEAD Curb				


DATE _____

TOWN OF LEXINGTON — BOARD OF PUBLIC WORKS

WATER DIVISION

Sketch of Service Here

242 B

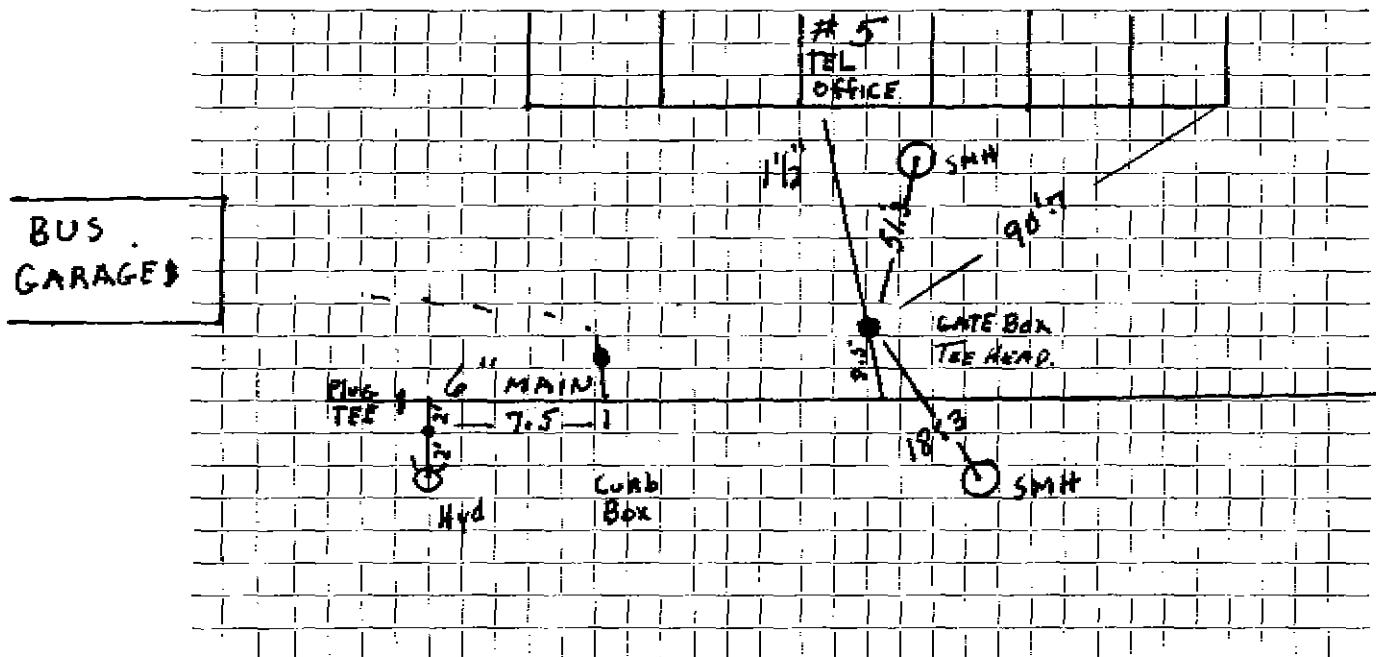

Connection made in Street. Work completed

Remarks: