

WATER SERVICE RECORD

#285

Name Leeland Construction Co.

Service No.

184

Address 245 Bedford Street

Location Lexington, Mass.

~~Repair XXXXXX~~ - New Service


Call 11-13-51

Date	Material	Amount	Total	Date		Amount
10/5/51	Labor	1 49	1 49	8-13-51	Deposited	10 00
	10% overhead		15	11-10-51	Paid	2 67
	60' -3/4" copper tubing @ .326	19 56			<u>NO CHARGE</u>	27 67
	1 -3/4" Cx 1/2" I.W.H. stop & waste	4 00		10/5/51	Labor	1 49
	1 -3/4" Cx 3/4" C. union (3 pts.)	1 72			18' -3/4" copper tubing @ .326	5 86
	1 hr. trucking		75		1 -3/4" C. corp-cock	4 33
			27 67		1 - 3/4" Cx 3/4" C. curb-cock	4 67
					1 box and rod	4 68
					1 -1/2 offset tail piece	50
					1 - 1/2 straight tail piece	50
					1 hr. trucking	75
						<u>22 78</u>
					<i>6-10-51</i>	

DATE _____

TOWN OF LEXINGTON — BOARD OF PUBLIC WORKS
WATER DIVISION

Sketch of Service Here

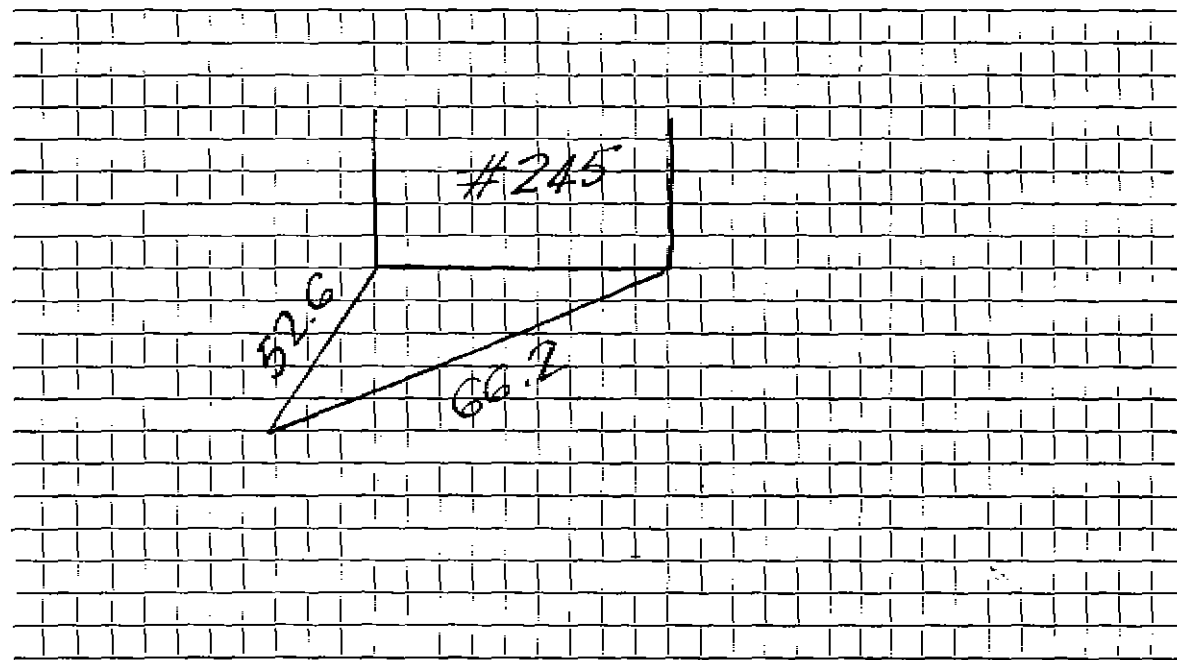

Connection made in Street. Work completed

Remarks:
.....
.....