


DATE 11/2000

TOWN OF LEXINGTON — BOARD OF PUBLIC WORKS

WATER DIVISION

Sketch of Service Here

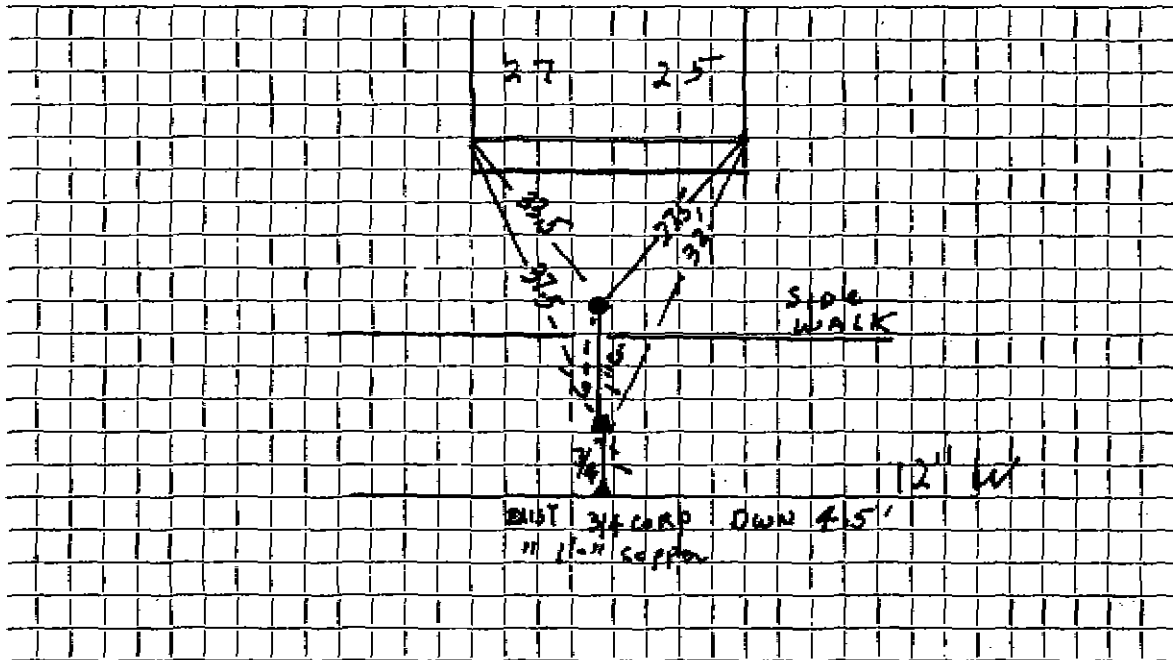

Connection made in Street. Work completed GRANESSE & SONS) DEFELISE.....

Remarks: USED EXIST. 3/4 COP. + 1' 3/4 COP.