

Name Colwell Brothers

Service No. ~~18~~ ^{#1716} 170

Address 122 Rawson Rd., Arlington
253 Bedford St.

Location ~~139~~ ²⁵³ Bedford Street

Kind of Pipe Size Size of Main

~~Repair - Renewal -~~ New Service

Date	Material	Amount	Total	Date	Amount
1935					
June 12	3 hrs. @ 55¢	1 65		1935	
<i>20.26 Com. to Russell & W. H. Co</i>	3 " @ 60¢	1 80		May 29	26 25
	10% Overhead on labor	35		July 16	6 05
	52' 1" C.L. Pipe @ 20¢	10 40			20 20
	3 1" L.L. Coup. @ 25¢	75			
	1 1" L.L. Ell	30			
	1 1" Brass Nipple	20			
	1 Stop & Waste	2 75			
	Trucking	2 00			
			20 20		
	Labor				

Expanded
3/4"
COPPER OUTSIDE
4/22/85 Jm

Hadley Press, Inc., Lexington

DATE 5-29-35

TOWN OF LEXINGTON—BOARD OF PUBLIC WORKS
WATER DIVISION

The undersigned applies for a supply of water at No. 153 Bedford St. and hereby agrees to comply with the rules and regulations as now, or at any future time, established by the Board of Selectmen.

Am't. of Estimate \$ 26.25


Owner Edwell Ross

Am't. Paid \$ _____

Address 122 Rawson Rd. Arlington

Builder _____

Sketch of Service Here

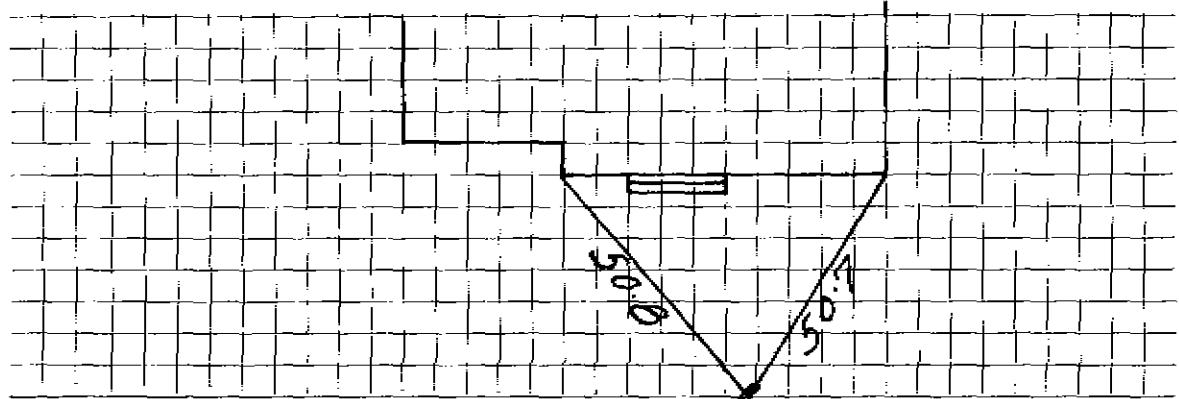

Connection made in _____ Street. Work completed _____ 19

Remarks: